


Section 2 Township 11 Range 18WWell No. 6 WatkinsCompany Continental

Burnett Pool

NORTH

WEST

EAST

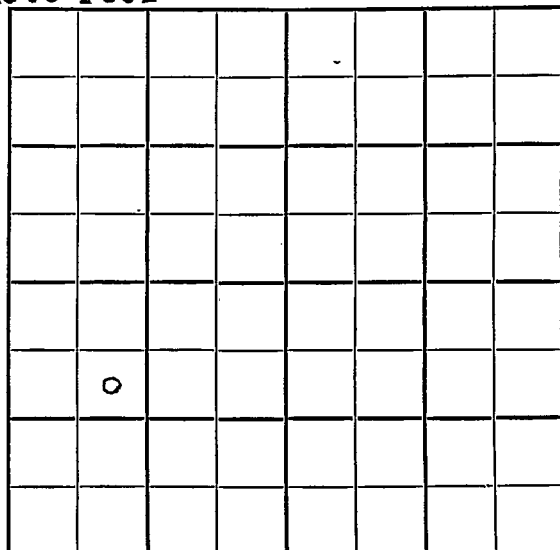

SOUTH

KANSAS Ellis

✓

Sec. 2 Twp. 11 R. 18W

Well No. #6 Watkins Farm


Continental Company

Burnett
990 Ft. from N. Line

 Ft. from S. Line

 Ft. from E. Line

990 Ft. from W. Line

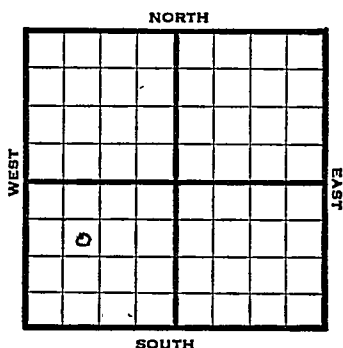

SE NW SW

1947	Elev. 1997' REPORT
10/15	10" @ 2053 WOC
10/22	Drlg. 2755'
10/29	Arbuckle 3525' TD 3528' 6" @ 3526' RUST
11/5	TD 3537' Swb 38 bbls oil PH, 2 hrs 500 Acid
11/12	Arbuckle 3525' 6" @ 3526' 300 Acid Depth Pot. 3000 Gr. 38° Total Depth 3537'
	COMPLETED

Map No. _____ Sec. 2 Twp. 11 R. 18W

Well No. 6 Watkins

Continental Company

FIRST REPORT

Contractor _____

SE NW SW

SECTION PLAT

990 Ft. from N. Line

_____ Ft. from S. Line

_____ Ft. from E. Line

990 Ft. from W. Line

Ellis County

Location _____

Rig up _____

Drilling and Remarks:

10" @ 205 WOC

RECORD

Cased _____ in., _____ ft.

Sand _____

Gas _____

Oil _____

Total Depth _____

PRODUCTION

1st 24 hrs. Nat. _____

1st 24 hrs. after shot _____

Gas _____ Cu. Ft.

Dry Hole _____

Abandoned _____

Date

OCT 15 1947 19

S. J. LEWIS Scout

Burnett Pool

Form 26 200 Bks. 10-46 Petrol
Kansas

Map No. 71 Sec. 2 Twp. 11 R. 18W

Well No. 6 Watkins

Continental

Company

COMPLETE

Contractor

SE NW SW


E. 1997
SECTION PLAT

990 Ft. from N. Line

 Ft. from S. Line

 Ft. from E. Line

990 Ft. from W. Line

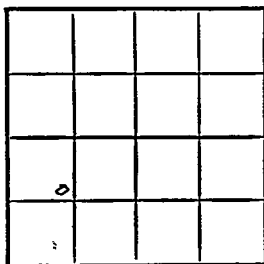

Ellis County

Location

Rig up

Drilling and Remarks:

*See logs
6" 08526
500' casing
Depth 2800'*

08526

RECORD

Cased in, ft.

Sand

Gas

Oil

Total Depth 2807

PRODUCTION

1st 24 hrs. Nat.

1st 24 hrs. after shot

Gas Cu. Ft.

Dry Hole

Abandoned

Date

NOV 12 1947 19

S. J. LEWIS

Scout