

Section 2 Township 11 Range 18WWell No. #7 Watkins SWDCompany Continental Oil Company

NORTH

		0					

WEST


EAST

SOUTH

6

Ellis

KANSAS

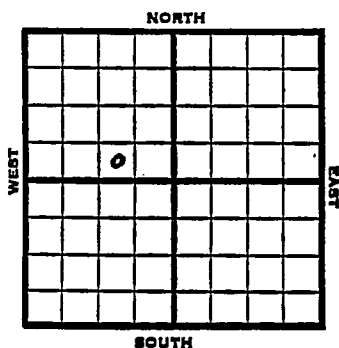Sec. 2 Twp. 11 R. 18 WWell No. # 7 Watkins SWD FarmContinental Oil CompanyStrain Drlg. Contractor Ft. from N. Line330 Ft. from S. Line990 Ft. from E. Line Ft. from W. Line

SW SE NW

1953

Elev. 1973: REPORT

2/25

Spud 2-17-53
 9-5/8" @ 1285' Anhy 1276'
 Drlg. 3000

3/12

Drlg. 3965'

3/19

G. Wash 4020' RTD 4035'
 Schl 7" @ 3591 CO 4035' 4000 A

3/26

NR

4/2

"

4/9

"

4/16

"

4/23

NR

4/30

"

5/7

NR

5/21

NR

5/28

"

6/3

"

6/10

Spud 2-17-53
 SWD Well
 TD 4035'
 9-5/8" @ 1285'
 Anhy 1276, Heeb 3164, Lans 3208
 DST 3357-83 rec 1300' mud packer
 failed.

OVER

1953

Information brought forward.

6/10 DST 3357-83 opn 1 hr, rec 945' sw
1200#
DST 3403-10 opn 1 hr, rec 15' mud
DST 3496-3518 opn 1 hr, rec 6' mud
0# Arb 3526'
DST 3516-48 opn 1 hr, rec 10' mud
190# Gra. Wash 4020
TD 4035
7" @ 3591'
CO to 4035'
4000 A
Comp. for SWD Well.

ABANDONED

County Ellis State Kansas
 Sec. 2 (Blk.) 11 (Sur.) 18W Map No. 11
 Operator Continental Oil
 Well No. 7 Farm Watkins SWD
 Elev. Location SW SE NW

0

FIRST REPORT

330 Ft. From S Line NW
990 Ft. From E Line Quarter
 Ist. Report FEB 25 1953

Completion

Remarks

Strain Drlg. - Contr.

Spudding Date 2-17-53

Drlg. Data

9 5/8 " @ 1285 Anhy 1276 drlg. 3000

J. G. McGEHEE


57

FEB 27 1953

Scout Cards	mm
Land Small Map	
Land Wall Map	35
Tracings	
France Map	
Pierce Map	
Misc.	

Orig. Data

County Ellis State Kansas
 Sec. 2 (Blk.) 11 (Sur. Rge.) 18W Map No.
 Operator Continental Oil
 Well No. 7 Farm Watkins SWD
 Elev. 1973 Location SW SE NW

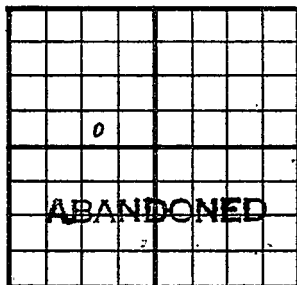

330 Ft. From S Line NW
990 Ft. From E Line Quarter
 1st. Report JUN 10 1953
 Completion
 Remarks Strain Drlg. - Contr.
 Spudding Date 2-17-53

Drlg. Data SWD well TD 4035
9 5/8" @ 1285 Anhy 1276 Heeb. 3164
Lans. 3208 DST 3357-83 Rec. 1300' mud
packer failed DST 3357-83 open 1 hr.
Rec. 945' sw 1200# DST 3403-10
open 1 hr. Rec. 15' mud DST 3496-3518
open 1 hr. Rec. 6' mud 0# Arb. 3526
DST 3516-48 open 1 hr. Rec. 10' mud
190# Gra. wash. 4020 TD 4035
7" @ 3591 CO to 4035 4000 A
Comp. for SWD well

J. G. McGEHEE

JUN 16 1953

Scout Cards

Land Small Map

Land Wall Map

Tracings

France Map


Aisc.

Drig. Data