

Sec. 2 Twp. 11S R. 18W

Well No. 2 Cross Farm _____

Mid-States Company _____

Burnett Pool


330 Ft. from N. Line

_____ Ft. from S. Line

_____ Ft. from E. Line

330 Ft. from W. Line

NW SE

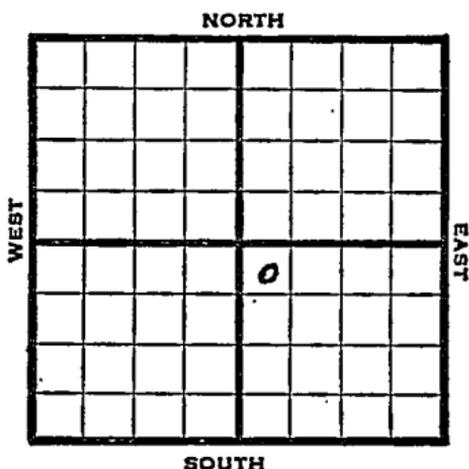

1947 Elev. 2003 REPORT

3/26 RUE

4/2 Drlg 1045'

4/9 10" @ 1310'
Drlg 2300'

4/15 Lansins 3247'
Drlg. 3430'

4/23 Arb 3540
7" @ 3540
TD 3546'
Swb 239 bbls oil in 3½ hrs

4/30 Arb 3540
7" @ 3540
500 Acid
Depth Pot 3700
Wax 3700
Grav. 33
TD 3546'

COMPLETED

Map No. 171 Sec. 2 Twp. 11 R. 18W

Well No. 2 Cross

Mid-States Company

FIRST REPORT

Contractor

NW SE

SECTION PLAT

330 Ft. from N. Line

_____ Ft. from S. Line

_____ Ft. from E. Line

330 Ft. from W. Line

| | | | |
|--|--|---|--|
| | | | |
| | | | |
| | | o | |
| | | | |

Ellis County

Location _____

Rig up _____

Drilling and Remarks:

R U R

RECORD

Cased _____ in., _____ ft.

Sand _____

Gas _____

Oil _____

Total Depth _____

PRODUCTION

1st 24 hrs. Nat. _____

1st 24 hrs. after shot _____

Gas _____ Cu. Ft.

Dry Hole _____

Abandoned _____

Date

MAR 26 1947 19

S. J. LEWIS Scout

Kansas

Map No. k71 Sec. 2 Twp. 11 R. 18W

Well No. 2 Cross

Mid-States Company

COMPLETE

Contractor

NW SE

E. 1, 2003

SECTION PLAT

330 Ft. from N. Line

_____ Ft. from S. Line

_____ Ft. from E. Line

330 Ft. from W. Line

| | | | |
|--|--|---|--|
| | | | |
| | | | |
| | | 0 | |
| | | | |

Ellis County

Location _____

Rig up _____

Drilling and Remarks:

*Cor 83540
7" @ 3540
500 cu. ft.
Depth 83700
May 3000
98 @*

RECORD

Cased _____ in., _____ ft.

Sand _____

Gas _____

Oil _____

Total Depth 2546

PRODUCTION

1st 24 hrs. Nat. _____

1st 24 hrs. after shot _____

Gas _____ Cu. Ft.

Dry Hole _____

Abandoned _____

Date

APR 30 1947 19

S. J. LEWIS Scout