

Trego KANSAS

Well No. 3 Cook

Company Peel-Hardman

6

EAST

SOUTH

Trego		KANSAS
SEC.	TWP.	R.
2	11	21 W
WELL NO.		
# 3 Cook		FARM
COMPANY		
Peel-Hardman		
CONTRACTOR		


1650 Ft. from N. Line

Ft. from S. Line

330 Ft. from E. Line

Ft. from W. Line

NE SE NW

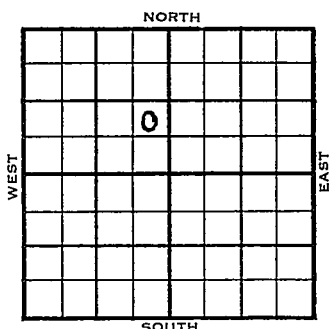


	ELEVATION	REPORT
1955	2086'	
2/2	Spud 1-16-55 8" @ 161 TD 3679' 5" @ 3674'	
3/9	Spud 1-16-55 Oil Well TD 3679' 8" @ 161' Heeb 3329 Top 3370', DST 3394'-3414' opn 1 hr, rec 540' s.w. DST 3453'-80' opn 1 hr, rec 390' s.w. DST 3488'-3530' opn 1/2 hr, rec 10' Mud 135# DST 3539'-86' opn 20 min, rec 6' Mud 540# B KC 3597' Arb. 3658' DST 3674'-79' opn 1/2 hr, rec 230' oil 780# TD 3679' 5" @ 3674' CO to 3679' S/ 3.34 boph 500 A S/ 11.67 boph 6 hr. Comp 311 bopd.	

COMPLETED

FABEN GILSTRAP

County Trego State Kansas
 Sec. 2 (Blk. 11 (Sur. 21W Map No.
 (Twp. (Rge.)
 Operator Peel-Hardman
 Well No. 3 Farm Cook
 Elev. 2086 Location NE SE NW

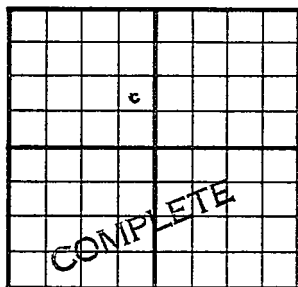

1650Ft. From N Line NW

330Ft. From E Line Quarter

1st. Report

Completion MAR 9 1955

Remarks

Spudding Date 1-16-55

Drlg. Data Oil well TD 3679

8" @ 161 Heeb. 3329 Top. 3370

DST 3394-3414 open 1 hr. Rec. 540' sw

DST 3453-80 open 1 hr. Rec. 390' sw

DST 3488-3530 open $\frac{1}{2}$ hr. Rec. 10' mud

135# DST 3539-86 open 20 min. Rec.

6' mud 540# B KC 3597 Arb. 3658

DST 3674-79 open $\frac{1}{2}$ hr. Rec. 230' oil

780# TD 3679 5" @ 3674 CO to 3679

S/ 3.34 boph 500 A S/ 11.67 boph 6 hr

Comp. 311 bopd

FABEN GILSTRAP