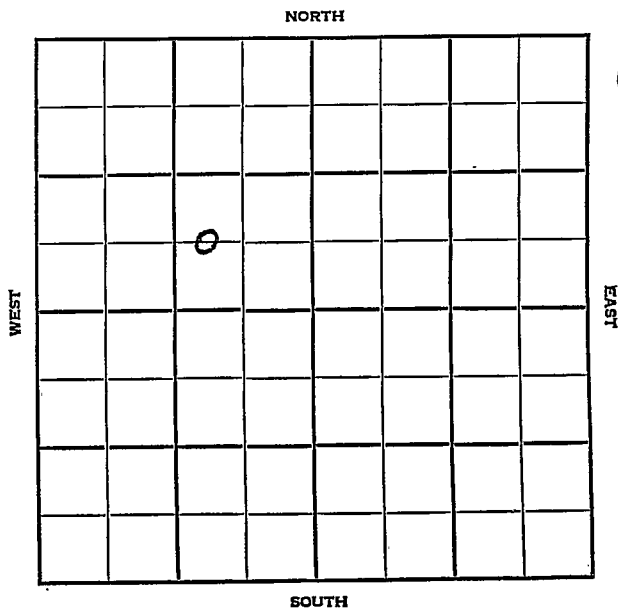


Section 2 Township 11 Range 21WWell No. 4 CookCompany Peel-Hardman

Trego

KANSAS

SEC.	TWP.	R.
2	11	21 W

WELL NO.

4 Cook

FARM

COMPANY

Peel-Hardman

CONTRACTOR

Co. tools


SW White Pool

_____ Ft. from N. Line

660 _____ Ft. from S. Line

_____ Ft. from E. Line

990 _____ Ft. from W. Line

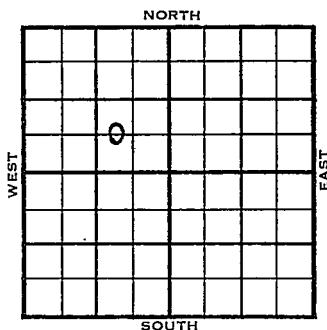C W $\frac{1}{2}$ SE NW

1955

ELEVATION

REPORT

2071'

2/2

Spud 1-29-55
 8" @ 163 Anhy 1520'
 Drlg.

3/23

Spud 1-29-55, Oil Well, TD3768
 8" @ 163; Anhy 1520, Heeb 3303,
 Lans 3344, DST 3419-64 open 1-hr
 Rec 1200' wtr, 1130#, Arb 3706
 TD 3768, 5" @ 3721, 18/3564-68,
 500A 24/3539-44, 2000A wtr, SP
 3534, 12/3525-29, 500A S/2 BOPH
 8 hr
 Comp 54 BOPD 34% wtr.

COMPLETED

County Trego State KansasSec. 2 (Blk. 11 (Sur. 21W Map No. 11) (Twp. 11 (Rge. 21W)Operator Peel-HardmanWell No. 4 Farm CookElev. 990 Location C W $\frac{1}{2}$ SE NW

660 Ft. From S Line NW990 Ft. From W Line QuarterFEB 2 1955
1st. Report

Completion


Remarks

Co. tools

Spudding Date 1-29-55Drlg. Data SW White Pool8" @ 163 Anhy 1520 drlg.

FABEN GILSTRAP

County Trego State Kansas
 Sec. 2 (Blk. 11) (Sur. 21W) Map No. 21W
 Operator Peel-Hardman
 Well No. 4 Farm Cook
 Elev. 2071 Location C W $\frac{1}{2}$ SE NW

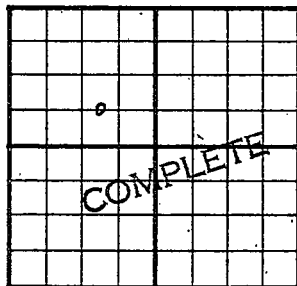

660 Ft. From S Line NW
990 Ft. From E Line Quarter

1st. Report
Completion MAR 23 1955
Remarks SW White Pool
Co. tools
Spudding Date 1-29-55

Drlg. Data Oil well TD 3768
8" @ 163 Anhy 1520 H₂Oeb. 3303
Lans. 3344 DST 3419-64 open 1 hr.
Rec. 1200' wtr. 1130# Arb. 3706
TD 3768 - 5" @ 3721 - 18/ - 3564-68 500 A
24/ 3539-44 2000 A wtr. SP 3534
12/ 3525-29 500 A S/ 2 boph 8 hr.
Comp. 54 bopd - 34% wtr.

FABEN GILSTRAP