

Map No. KANSAS Sec. 2 Twp. 11 R. 21W

Well No. B. F. Eaton Farm

B. F. Eaton Company

NORTH

WEST

EAST

	0						

SOUTH

Location.....

Drilling Remarks

Rig Up.....

Drilling Remarks 1779

RECORD

Cased..... in..... ft.

Sand.....

Gas.....

Oil.....

Total Depth.....

PRODUCTION

1st 24 hrs. Nat.....

1st 24 hrs. after shot.....

Gas..... cu. ft.....

Dry Hole.....

Abandoned.....

Map No. KANSAS Sec. 2 Twp. 11 R. 21W

Well No. 17 Caton Farm


P. E. Day Company

230 Ft. from N. Line

_____ Ft. from S. Line

_____ Ft. from E. Line

990 Ft. from W. Line

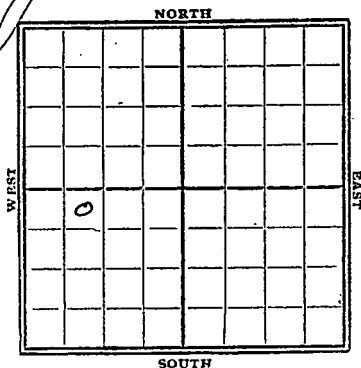

1929

Date

REPORT

5/22	1 Co G
5/22	—
5/29	Rig
6/5	Spind
6/12	12" - 509 wrlg 575
6/19	wrlg 840'
6/26	" 1325
7/2	" 1495
7/10	VIR 10" - 1565'
7/17	drlg 1575'
7/23	" 2230'
7/31	" 2667
8/7	VIR 8" - 2910'
8/14	S.D. 2910'
8-21	—
8/28	—
9/4	—
9/11	—
9/18	—
9/25	—
10/2	—
10/9	—

10/16 —
10/23 - S.D. 2910'
10/30 - set 8" 2890'
dry 3040'
11/6 - Cement case 3175'
11/13 —
11/20 - dry 3250
11/27 - S.D. 3250
12/4 —
12/11 —
12/18 —
12/23 —
12/30 —
1930
1/8 - U.R. 6" 3415'
1/15 - S.D. 3415'
1/22 —
1/29 —
2/5 - Run 6" 3412 (S.L.M.)
2/12 - Dry 3456'
2/19 - Dry 3649 - show
oil at 3470-75-
show oil 3560-63
2/26 - U.R. 6" 3820
3/5 - S.D. 3865'
3/12 - T.D. 3871
Dry & Abandon

Map No. KANSAS Sec. 2 Twp. 11 R. 2/W

Well No. 1, Eaton

R. E. Day Company

Contractor

SECTION PLAT

320 Ft. from N. Line

..... Ft. from S. Line

..... Ft. from E. Line

990 Ft. from W. Line

FIRST REPORTS

Location.....

Rig up.....

Drilling and Remarks:

ROG

RECORD

Cased.....in.,ft.

Sand.....

Gas.....

Oil.....

Total Depth.....

PRODUCTION

1st 24 hrs. Nat.....

1st 24 hrs. after shot.....

Gas.....Cu. Ft.

Dry Hole.....

Abandoned.....

Date

MAY 22 1929

192

S. J. LEWIS Scout

70 *790*
 Map No. KANSAS Sec. 2 Twp. 11 R. 2/W

Well No. 1 Eaton

R. E. Day Company

Contractor

SECTION PLAT

830 Ft. from N. Line

_____ Ft. from S. Line

_____ Ft. from E. Line

990 Ft. from W. Line

o			

ABANDONED

Location _____

Rig up _____

Drilling and Remarks:

RECORD

Cased _____ in., _____ ft.

Sand _____

Gas _____

Oil _____

Total Depth 387 1/2

PRODUCTION

1st 24 hrs. Nat. _____

1st 24 hrs. after shot _____

Gas _____ Cu. Ft.

Dry Hole _____

Abandoned _____

Date

MAR 12 1930

S. J. LEWIS

Scout