


Trego

SECTION 2 TOWNSHIP 11 RANGE 21 W

WELL NO. "8 Cook

COMPANY Peel-Hardman

NORTH

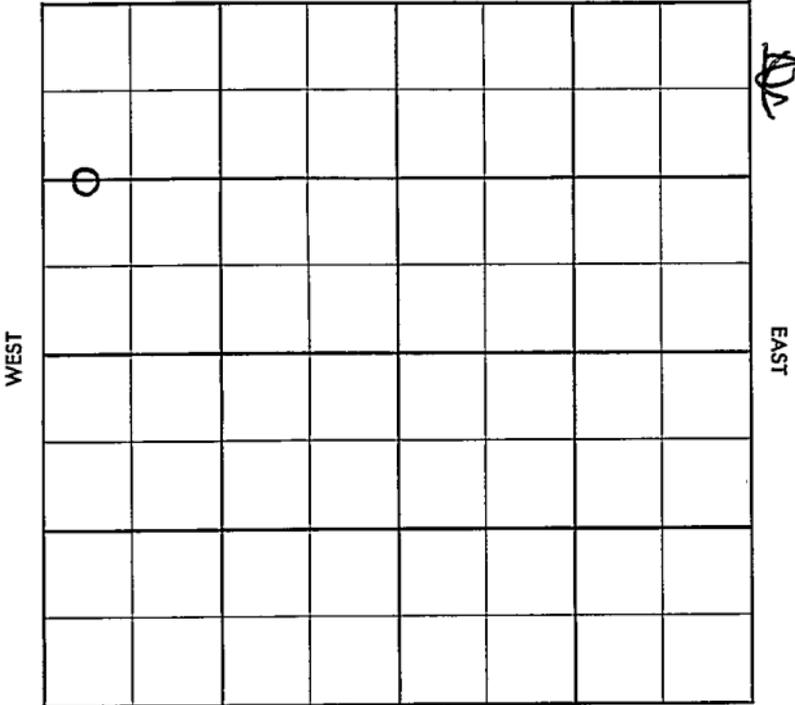

SOUTH

Trego

KANSAS

SEC. 2	TWP. 11	R. 21W
-----------	------------	-----------

WELL NO. #8 Cook FARM

COMPANY Peel - Hardman

CONTRACTOR Co. Tools


SW White

\_\_\_\_\_ Ft. from N. Line

\_\_\_\_\_ Ft. from S. Line

\_\_\_\_\_ Ft. from E. Line

\_\_\_\_\_ Ft. from W. Line

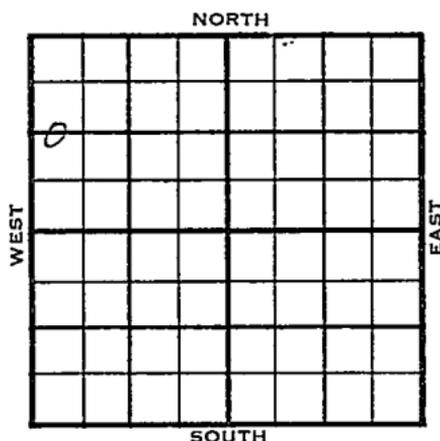C  $W\frac{1}{2}$   $W\frac{1}{2}$  NW

1956	ELEVATION	REPORT
	2082	

1-18	Comm. 1-14-56 8" @ 190/140 Drlg. 2030
3-21	DST 3367-92 op $\frac{1}{2}$ hr. rec. 70' so&gcm 1090/15" DST 3410-35 op 1 hr. rec. 445' so&gcm 1235/20" 5 $\frac{1}{2}$ " @ 3652/500 DD 3655 FU 1000' oil, 1 hr., 500 A, S/ 21 boph 8 hrs., Comp. 3000 bopd Anh. 1523 Tp. 3093 H. 3302 Tr. 3322 L. 3340 BKC 3571 A. 3635 TD 3653

COMPLETED

County Trego Elev. \_\_\_\_\_  
 Sec. 2 Twp. 21N Rge. 21W  
 Company Peel-Harman  
 Farm Name Cook No. 8

TOPS	DEPTH	LOG	DATUM	Loc. in Sec.
Anh.				G W $\frac{1}{2}$ W $\frac{1}{2}$ NW
Tp.				
H.				
Tr.				
Dg.				
Bl.				
L.				Geol. _____
K.C.				Contr. _____
B.K.C.				
Ce.				Co. tools
C.				
M.				Pool
K.				SW White
Mz.				
Ma.				
V.				
S.				
S.				
A.				
R.				
Pe.				
G.				
T.D.				

FIRST REPORT  
 JAN 12 '56

Date Comm. 1-14-56  
8" @ 190/140 drlg. 2030

*(Large handwritten mark, possibly a signature or initials)*

Co.  
Lse.  
No.  
Sec.  
T.  
R.

County Trego Elev. 2082  
 Sec. 2 Twp. 17 Rge. 21W  
 Company Peel-Hardman  
 Farm Name Cook No. 8

TOPS	DEPTH	LOG	DATUM	Loc. in Sec.	
Anh.	1523			C W $\frac{1}{2}$ W $\frac{1}{2}$ NW	
TP.	3093	
H.	3302	
Tr.	3322	
Dg.	
Bl.	
L.	3340		1258	Geol.	
K.C.				Contr.	
B.K.C.	3571		1489	Co. tools	
Ce.				Pool	
C.				SW White	
M.				<table border="1"> <tr><td></td><td></td><td></td><td></td></tr> </table>	
M.	
K.	
Mz.	
Me.	
V.	
S.	
S.	
A	3635		1553	
R.	
PE.	
G.	
T.D.	3653	

Date Comm. 1-11-56 MAR 2 1 1956  
 8" @ 190/140 DST 3367-92 open  $\frac{1}{2}$  hr.  
 rec. 70' so & gcm 1090/15" DST 3410-35  
 open 1 hr. rec. 445' so & gcm 1235/20"  
 5  $\frac{1}{2}$ " @ 3652/500 DD 3655 FU 1000' oil  
 1 hr. 500 A S/ 21 boph 8 hr.  
 Comp. 3000 bopd