


KANSAS Ellis

Sec. 2 Twp. 11 R. 18W

Well No. #5 Watkins Farm
Continental Company
Burnett

330 Ft. from N. Line
 Ft. from S. Line
 Ft. from E. Line
330 Ft. from W. Line
NW SW

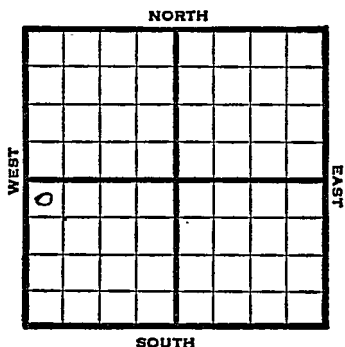

1947 Elev. 1997' REPORT

8/6	Location
8/13	"
8/20	"
8/27	"
9/3	"
9/10	"
9/17	"
9/24	RUR
10/1	10" @ 205' Drlg. 2325'
10/8	Drlg. 3279'
10/15	Arbuckle 3525' TD 3528' 6" @ 3526' RUST
10/22	"
10/29	Arbuckle 3525' 6" @ 3526' 500 Acid Bom & Pot 3000 TD 3534' Gravity 37

COMPLETED

Kansas Burnett

Map No. _____ Sec. 2 Twp. 11 R. 18WWell No. 5 Watkins_____
Continental Company**FIRST REPORT** Contractor _____

MW SW

SECTION PLAT

0			

330 Ft. from N. Line

_____ Ft. from S. Line

_____ Ft. from E. Line

330 Ft. from W. LineEllis CountyLocation X

Rig up _____

Drilling and Remarks:

RECORD

Cased _____ in., _____ ft.

Sand _____

Gas _____

Oil _____

Total Depth _____

PRODUCTION

1st 24 hrs. Nat. _____

1st 24 hrs. after shot _____

Gas _____ Cu. Ft.

Dry Hole _____

Abandoned _____

Date

AUG 6 1947 19 _____ S. J. LEWIS Scout

Map No. 71 Sec. 2 Twp. 11 R. 18W

Well No. 5 Watkins

Continental

Company

COMPLETE

Contractor

NW SW


E 11/997
SECTION PLAT

330 Ft. from N. Line

_____ Ft. from S. Line

_____ Ft. from E. Line

330 Ft. from W. Line

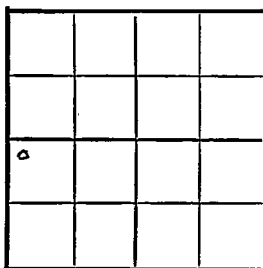

Ellis County

Location _____

Rig up _____

Drilling and Remarks:

Ar 73525

6" @ 3526

500 acid

Bom 73525 3000

37 1/2 ft

RECORD

Cased _____ in., _____ ft.

Sand _____

Gas _____

Oil _____

Total Depth 3534

PRODUCTION

1st 24 hrs. Nat. _____

1st 24 hrs. after shot _____

Gas _____ Cu. Ft.

Dry Hole _____

Abandoned _____

Date

OCT 29 1947 19

S. J. LEWIS

Scout