

Ellis

KANSAS
16W

20


11

SECTION _____ TOWNSHIP _____ RANGE _____

WELL NO. #2 Potter

COMPANY Franco-Central

NORTH

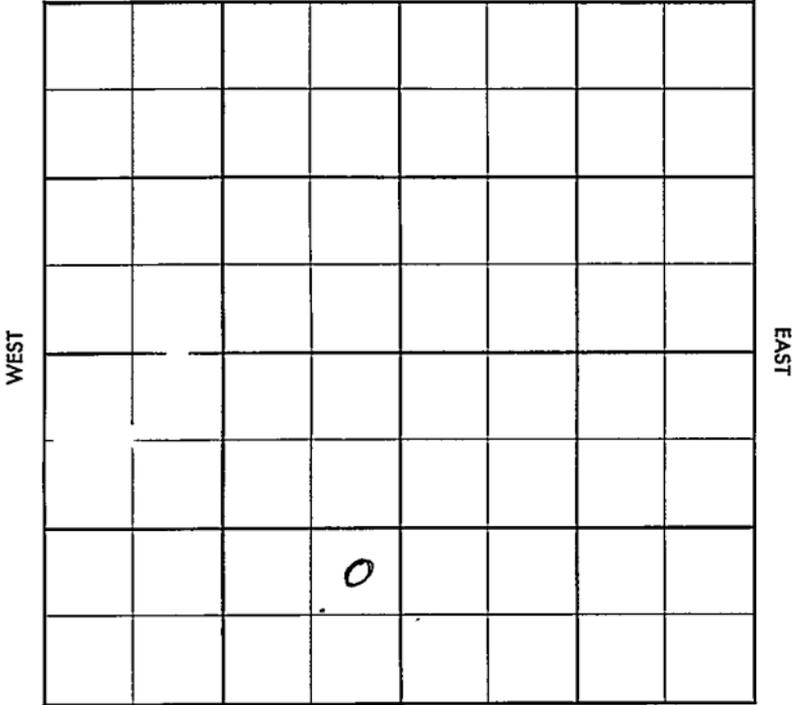

SOUTH

Ellis

KANSAS

SEC.	TWP.	R.
20	11	16W

WELL NO. #2 Potter FARM

COMPANY Franco-Central

CONTRACTOR Lewis Tools


Potter

_____ FT. FROM N. LINE

_____ FT. FROM S. LINE

_____ FT. FROM E. LINE

_____ FT. FROM W. LINE

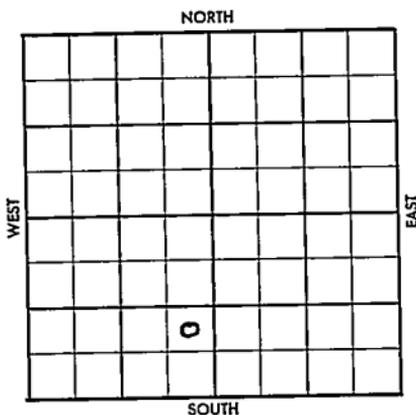

NE SE SW

1956	ELEVATION	REPORT
------	-----------	--------

9-12

MIRT

County Ellis Elev. _____
 Sec. 20 Twp. 11 Rge. 16W
 Company Franco-Central
 Farm Name Potter No. 2

TOPS	DEPTH	LOG	DATUM	Loc. in Sec.
Anh.				NE SE SW
TP.				
H.				
Tr.				
Dg.				
Bl.				
L.				Geol. _____
K.C.				Contr. _____
B.K.C.				Lewis Tools
Ce.				
C.				Pool
M.				Potter
M.				
K.				
Mz.				
Ma.				
V.				
S.				
S.				
A.				
R.				
PE.				
G.				
T.D.				

SEP 12 '55
 FIRST REPORT

Date Comm. MIRT

Co.
 Lse.
 No.
 Sec.
 T.
 R.

County ELLIS Elev. 1824
 Sec. 20 Twp. 11 Rge. 16W
 Company Franco-Central
 Farm Name Potter No. 2

TOPS	DEPTH	LOG	DATUM	Loc. in Sec.
Anh.				NE SE SW
TP.	2734			
H.	2980			
Tr.	3004			
Dg.				
Bl.				
L.	3026			Geol.
N.C.				Contr.
RKC.	3272			Lewis Tools
Ce.				Pool
C. <u>cherty</u>	3336			Potter
M.				<div style="border: 1px solid black; padding: 5px; text-align: center;"> ABANDONED SEP 26 '56 0 </div>
M.				
K.				
Mz.				
Mo.				
V.				
S.				
S.				
A.				
R.				
PE.				
G.				
TD.	3452			

Date Comm. MIRT SEP 19 '56 9-12-56 858
999/500 @ 3090 SEP 26 '56
no Log
D & A