


Ellis

KANSAS

SECTION 20 TOWNSHIP 11S RANGE 16W

WELL NO. #13 Potter

COMPANY Franco-Central

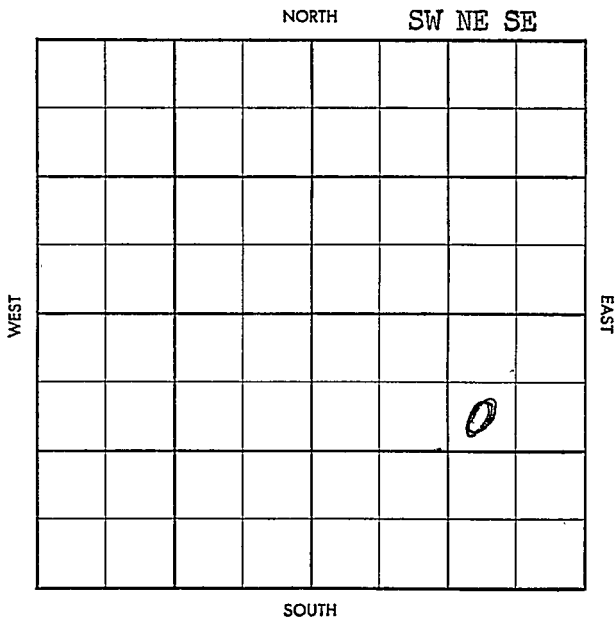

513-B

Co.

Ese.

No.

Sec.

T.

R.

County Elvis Elev. 1748 RB
 Sec. 20 Twp. 11 Rge. 16W 1745 DP
 Company Franco-Central
 Farm Name Potter No. 13

TOPS	DEPTH	LOG	DATUM
Anh.	<u>916</u>		
Tp.			
H.	<u>2923</u>		
Tr.	<u>2943</u>		
Dg.			
B.L.			
L.			
L.K.C.	<u>2972</u>		
B.K.C.			
Ca.			
C.	<u>3277</u>		
M.			
M.			
K.			
Mz.			
Mq.			
V.			
S.			
S.			
A.			
R.			
Pf.			
G.			
T.D.	<u>3348</u>		

Lac. in. Sec. SW NE SE
 Geol. _____
 Contr. _____
Red Tiger
 Poof _____
Potter

ABANDONED
 FEB 19 '58

Date Comm. 2-2-58 8" 575/450
 Location FEB 5 '58 0935 FEB 12 '58 03348
 FEB 19 '58 NO LOG ON TESTS

D6A