

KANSAS

Ellis


Form 51-5M-7-40-Palace

Section 20 Township 11 Range 16-W

Well No. #1 Botter "A"

Company Lario

NORTH Bemis Pool

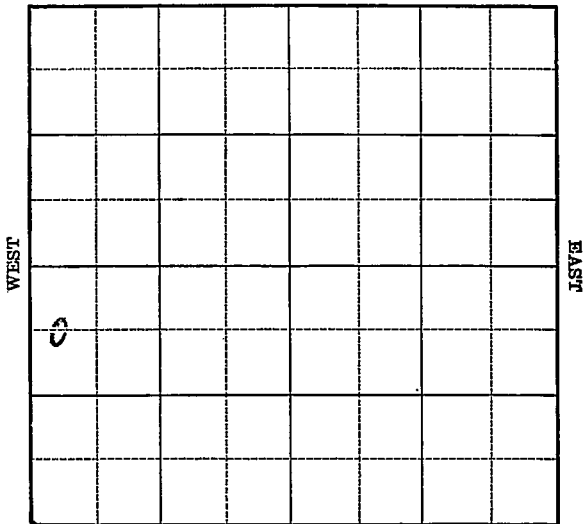

SOUTH

Map No. 71 Sec. 20 Twp. 11 R. 16W

Well No. 1 Botter "A"

Lario Company

Contractor

FIRST REPORT

SECTION PLAT

C W L NW SW

660 Ft. from N. Line

_____ Ft. from S. Line

_____ Ft. from E. Line

330 Ft. from W. Line

Bemis Pool

Location _____

Rig up _____

Drilling and Remarks:

Derrick

RECORD

Cased _____ in., _____ ft.

Sand _____

Gas _____

Oil _____

Total Depth _____

PRODUCTION

1st 24 hrs. Nat. _____

1st 24 hrs. after shot _____

Gas _____ Cu. Ft.

Dry Hole _____

Abandoned _____

Date

OCT 23 1940 19

S. J. LEWIS

Scout

Map No. 71 Sec. 20 Twp. 11 R. 16W

Well No. 1 Botter "A"

Lario Oil & Gas Company

Contractor

COMPLETED

C W L NW SW

SECTION PLAT

660 Ft. from N. Line

_____ Ft. from S. Line

_____ Ft. from E. Line

330 Ft. from W. Line

BEMIS POOL

RECORD

Location _____

Rig up _____

Drilling and Remarks: .

cu & 3560

Cong 8360

BHC 8829

No show.

Cased _____ in., _____ ft.

Sand _____

Gas _____

Oil _____

Total Depth 3566

PRODUCTION

1st 24 hrs. Nat. _____

1st 24 hrs. after shot _____

Gas _____ Cu. Ft.

Dry Hole _____

Abandoned _____

Date

NOV 13 1940 19

S. I. LEWIS Scout