


Section 20 Township 11 Range 15W

Well No. #2 Brunson

Company Summitt Oil

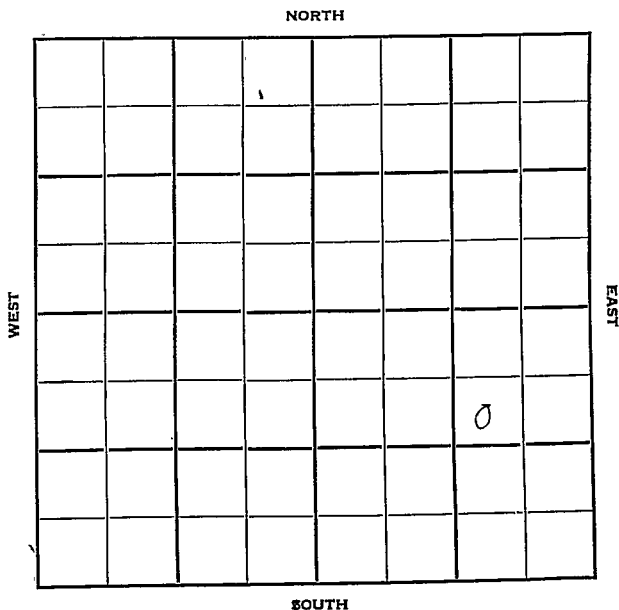

Sec. 20 Twp. 11 R. 15W

Well No. #2. Brunson Farm

Summitt Oil Company

Stearns Drlg. Contractor

Fairport Pool


990' Ft. from N. Line

_____ Ft. from S. Line

990' Ft. from E. Line

_____ Ft. from W. Line

SW NE SE

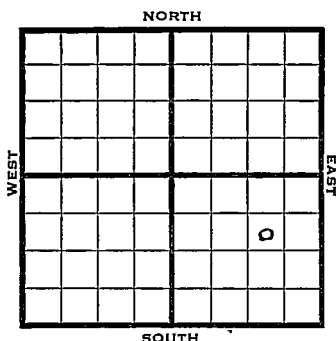

1950

Elev 1813

REPORT

3/22

RUR

5/17

TD 3330

8" @ 745

Lans 2936

Cong 3258

Simp 3310

5" @ 3330

plug back to 3010

pay 3121-29

3146-54 in lanning~

P 20 BOPD

Completed

COMPLETED

Map No. _____ Sec. 20 Twp. 11 R. 15W

Well No. 2 Brunson

Summitt Oil _____ Company

Stearns Drlg. _____ Contractor

SW NE SE

SECTION PLAT

990 Ft. from N. Line

_____ Ft. from S. Line

990 Ft. from E. Line

_____ Ft. from W. Line



Russell County

Location _____

Rig up _____

Drilling and Remarks:

R U R

RECORD

Cased _____ in., _____ ft.

Sand _____

Gas _____

Oil _____

Total Depth _____

PRODUCTION

1st 24 hrs. Nat. _____

1st 24 hrs. after shot _____

Gas _____ Cu. Ft.

Dry Hole _____

Abandoned _____

Date

MAR 22 1950 19

J. E. TYRA Scout

Kansas

Map No. _____ Sec. 20 Twp. 11 R. 15WWell No. 2 Brunson

Summitt Oil

Company

Contractor

SW NE SE

E1. 1813
SECTION PLAT990 Ft. from N. Line

_____ Ft. from S. Line

990 Ft. from E. Line

_____ Ft. from W. Line

COMPLETE			o

Russell

Location _____

Rig up _____

Drilling and Remarks:

8" @ 745

Lanz 2936

Cong 3258

Simp 3310

5" @ 3330

plug back to 3010

pay 3121-29

3146-54 in casing

Date

P20BOPD

MAY 17 1950

19

RECORD

Cased _____ in., _____ ft.

Sand _____

Gas _____

Oil _____

Total Depth 3330

PRODUCTION

1st 24 hrs. Nat. _____

1st 24 hrs. after shot _____

Gas _____ Cu. Ft.

Dry Hole _____

Abandoned _____

J. E. TYRA

Scout