


Section 20 Township 11 Range 15-W

Well No. #1 Korton

Company Ferrell Drlg.

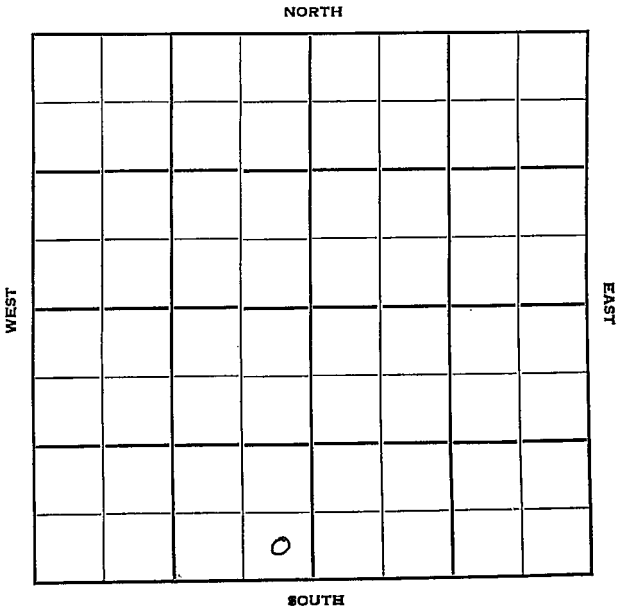

Russell KANSAS

Sec. 20 Twp. 11 R. 15W

Well No. #1 Korton Farm

Ferrell Drlg. Company

Ferrell Drlg. Contractor

Fairport Pool


 Ft. from N. Line

330' Ft. from S. Line

330' Ft. from E. Line

 Ft. from W. Line

SE SE SW

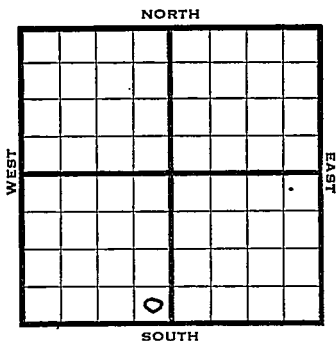

1950	Elev 1831	REPORT
7/5	Rig up	
8/30	8" @ 313 Anhy 908 Cong 3246 5 1/2" @ 3291 TD 3333 A/10 1/2 boph Completed	Lans 2949 Arb 3291-97 250A P/70 bo 20 bwpd
	COMPLETED	

Kansas

Map No. _____ Sec. 20 Twp. 11 R. 15W

Well No. 1 Korton

Ferrell Drlg. _____ Company

Ferrell Drlg. _____ Contractor

SE SE SW


SECTION PLAT

_____ Ft. from N. Line

330 Ft. from S. Line

330 Ft. from E. Line

_____ Ft. from W. Line

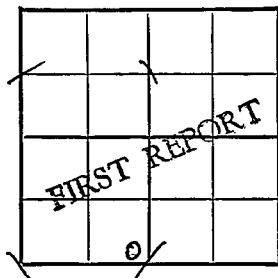

Russell County

Location _____

Rig up ☒

Drilling and Remarks:

RECORD

Cased _____ in., _____ ft.

Sand _____

Gas _____

Oil _____

Total Depth _____

PRODUCTION

1st 24 hrs. Nat. _____

1st 24 hrs. after shot _____

Gas _____ Cu. Ft.

Dry Hole _____


Abandoned _____

Date

JUL 5 1950 19

J. E. TYRA Scout

County Russell State Kansas
 Sec. 20 (Blk. 11 (Sur. 1 5W Map No. 11)
 Operator Ferrell Drlg.
 Well No. 1 Farm Korton
 Elev. 1831 Location SE SE SW

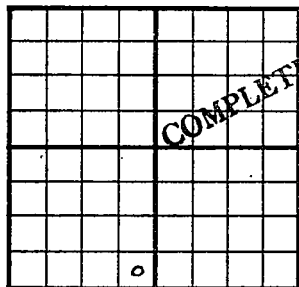

330 Ft. From S Line SW
330 Ft. From E Line Quarter

Ist. Report

Completion AUG 30 1950

Remarks

Fairport Pool

Spudding Date

Drlg. Data Oil well TD 3333
8" @ 131 Anhy 908 Lans. 2949 Cong. 3246
Arb. 3291-97 5 $\frac{1}{2}$ " @ 3291 TD 3333
A/ 10 $\frac{1}{2}$ boph 250 A P/ 70 bo 20 bwpd
Comp.

J. E. TYRA