

Section 20 Township 11 Range 15 W

Well No. # 2 Korton

Company Ferrell Drlg.

NORTH

			0				

WEST

EAST

SOUTH

Russell

KANSAS

Sec. 20 Twp. 11 R. 15 W

Well No. # 2 Korton Farm

Ferrell Drlg. Company

Contractor

Fairport Pool


Ft. from N. Line

990 Ft. from S. Line

330 Ft. from E. Line

Ft. from W. Line

NE SE SW

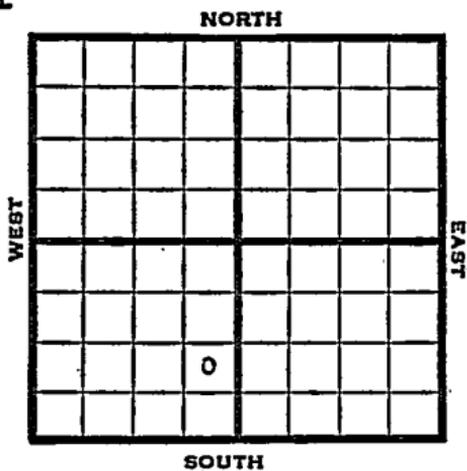

1951

Elev. 1819' REPORT

7/11

RUR

9/5

Spud 7-23-51

Oil Well TD 3361

8" @ 130

Top 2643 Heeb. 2898

Lans. 2946 Arb. 3259

TD 3361 5" @ 3361

24/3300-04 S/6 boph

Comp. 50 bopd

COMPLETED

