



Russell

Map No. Tans Sec. 20 Twp. 11 R. 15W

Well No. 1 Farm.


Streeter & Stearns Company

\_\_\_\_\_ Ft. from N. Line

300 Ft. from S. Line

990 Ft. from E. Line

\_\_\_\_\_ Ft. from W. Line

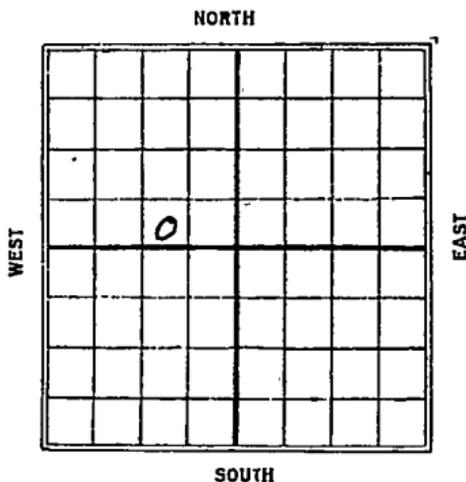

1926

Date	REPORT
9/1	Location
9/22	_____
9/29	_____
10/6	same
10/13	_____
10/20	rigging up
10/27	_____
11/3	Spud
11/10	Drlg 365
11/17	" 525
11/24	" 913
12/1	" 1000
12/8	" 1075'
12/21	J.D. 1044 S.D.
12/29	same
1927	_____
1/5	_____
1/12	_____
1/19	S. & A. 1044

Map No. **KANSAS** Sec. 20 Twp. 11 R. 15N

Well No. 1

Street & Stearns Company

Contractor

SECTION PLAT

	0		

----- Ft. from N. Line

300 Ft. from S. Line

990 Ft. from E. Line

----- Ft. from W. Line

FIRST REPORTS

Location -----

Rig up -----

Drilling and Remarks:

Location.

RECORD

Cased ----- in., ----- ft.

Sand -----

Gas -----

Oil -----

Total Depth -----

PRODUCTION

1st 24 hrs. Nat. -----

1st 24 hrs. after shot -----

Gas ----- Cu. Ft.

Dry Hole -----

Abandoned -----

Date

SEP 1 1926

S. J. LEWIS

Scout

Map No. KANSAS Sec. 20 Twp. 11 R. 15W

Well No. 1 Liebell

Streeter & Sterns Company

Contractor

SECTION PLAT

	0		

----- Ft. from N. Line

300 Ft. from S. Line

990 Ft. from E. Line

----- Ft. from W. Line

**ABANDONED**

Location -----

Rig up -----

Drilling and Remarks:

*TII 1044  
Running soft  
core*

*T & A.*

RECORD

Cased        in., ----- ft.

Sand -----

Gas -----

Oil -----

Total Depth -----

PRODUCTION

1st 24 hrs. Nat. -----

1st 24 hrs. after shot -----

Gas ----- Cu. Ft.

Dry Hole -----

Abandoned -----

Date

JAN 19 1927

192

*S. J. LEWIS*

Scout