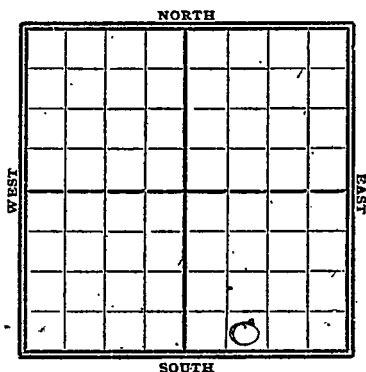


Map No. KANSAS Sec. 20 Twp. 11 R. 15wWell No. 33-Bronse FarmMid West, Hawes Company

..... Ft. from N. Line

330 Ft. from S. Line

..... Ft. from E. Line

990 Ft. from W. Line1928

Date

REPORT

<u>7/25</u>	<u>ROG.</u>
<u>8/1</u>	<u>Bldg rig</u>
<u>8/7</u>	<u>Rig</u>
<u>8/15</u>	<u>I</u>
<u>8/22</u>	<u>Rig up.</u>
<u>9/5</u>	<u>_____</u>
<u>9/12</u>	<u>_____</u>
<u>9/19</u>	<u>Drly 431'</u>
<u>9/26</u>	<u>" 795'</u>
<u>10/3</u>	<u>" 1190'</u>
<u>10/10</u>	<u>" 1990'</u>
<u>10/17</u>	<u>" 2425'</u>
<u>10/24</u>	<u>" 2690'</u>
<u>10/31</u>	<u>Top Oswald 2965 sho</u>
	<u>HFW 2981'</u>
<u>11/7</u>	<u>sand 3131-50</u>
	<u>1000' oil in 3 hrs.</u>
	<u>Drly 3156'</u>
<u>11/14</u>	<u>sand 3131'</u>
	<u>TD 3178'</u>
	<u>swabbed 36 bbls oil</u>
	<u>42 gravity <u>Somp</u></u>

Map No. KANSAS Sec. 20 Twp. 11 R. 15W

Well No. 33 Bronse

Mid West & Harse Company

Contractor

SECTION PLAT

-----Ft. from N. Line

330 Ft. from S. Line

-----Ft. from E. Line

990 Ft. from W. Line

FIRST REPORTS

Location -----

Rig up -----

Drilling and Remarks:

ROG

RECORD

Cased ----- in., ----- ft.

Sand -----

Gas -----

Oil -----

Total Depth -----

PRODUCTION

1st 24 hrs. Nat. -----

1st 24 hrs. after shot -----

Gas ----- Cu. Ft.

Dry Hole -----

Abandoned -----

Date

JUL 25 1928

S. J. LEWIS

192

Scout

Russell
No name
 MAP NO. KANSAS SEC. 20 TWP. 11 R. 15W

WELL NO. 33 Brown

Mid-West-Hawse COMPANY

CONTRACTOR

SECTION PLAT

_____ FT. FROM N. LINE

330 FT. FROM S. LINE

_____ FT. FROM E. LINE

990 FT. FROM W. LINE

COMPLETED

RECORD

LOCATION _____

CASED _____ IN. _____ FT.

RIG UP _____

SAND _____

DRILLING AND REMARKS:

GAS _____

OIL _____

TOTAL DEPTH 3178

PRODUCTION

1ST 24 HRS. NAT. _____

1ST 24 HRS. AFTER SHOT _____

GAS _____ CU. FT.

DRY HOLE _____

ABANDONED _____

DATE

NOV 14 1928

S. J. LEWIS

SCOUT

Land 3131
Total Depth 3178
swatted 36.846
42 grave ty