


Section 20 Township 11 Range 18W

Well No. #1 Wassinger

Company C & G Drlg.

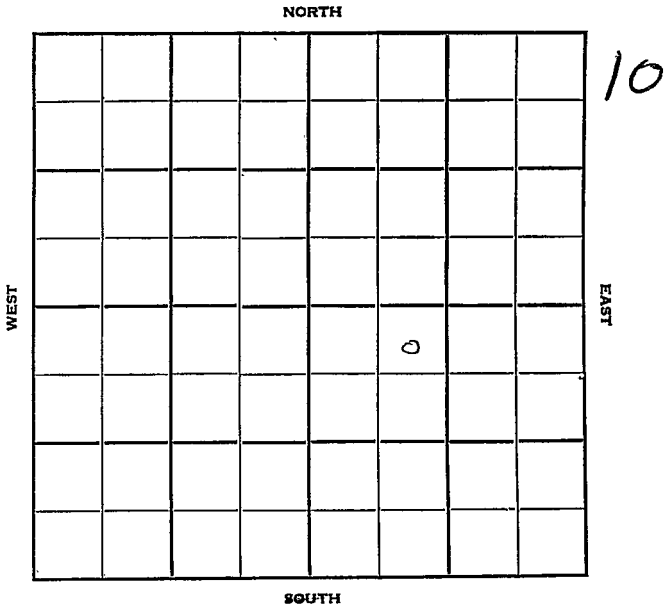

Ellis

KANSAS



Sec. 20 Twp. 11 R. 18W

Well No. #1 Wassinger Farm

C & G Drlg. Company

Contractor

Riverview Pool


330' Ft. from N. Line

Ft. from S. Line

Ft. from E. Line

990' Ft. from W. Line

NE NW SE

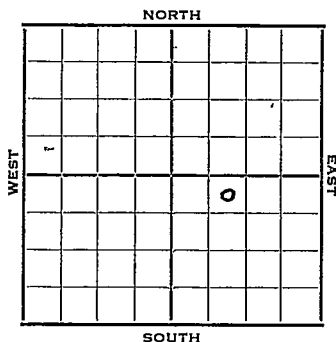

1952

Elev. 2077'

R E P O R T

3/19

Location

3/25

8" @ 211 WOC

4/1

Anhy 1377

Heeb. 3280

Tor. 3300

Lans. 3322

DST 3353-64,  $\frac{1}{2}$  hr. 260' wtr.

30 OCM 900#

Drlg. 3370'

4/9

Arb. 3618' RTD 3622

5" @ 3619'

4/23

DP DD to 3633' Arb. 3632' Cor.

DD 3637' 500 A S/70 BO 12 hrs. POP

4/30

NR

5/7

"

5/14

"

5/21

"

5/28

NR

6/11

"

6/18

"

6/25

NR

7/2

25 BOPD

OVER

1952

7/9

Spud 3-21-52

Oil well TD 3637' 8" @ 211

Anhy 1377' Heeb 3280' Tor. 3300'

Lans. 3322'

DST 3353-64 open  $\frac{1}{2}$  hr. rec 260' water  
30' OCM

TD 3622 5" @ 3619 Arb. 3632'

DD 3637' 500 A S/70 BO 12 hr.

Comp. 25 BOPD


**COMPLETED**

County **Ellis** State **Kansas**  
 Sec. **20** (Blk. Twp.) **11** (Sur. Rge.) **18W** Map No.

Operator **C & G Drlg.**

Well No. **1** Farm **Wassinger**

Elev. Location **NE NW SE**

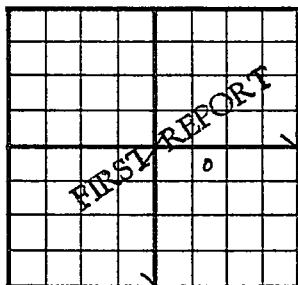

**330** Ft. From **N** Line **SE**

**990** Ft. From **W** Line Quarter

Ist. Report **MAR 1 9 1952**

Completion

Remarks

Spudding Date

Drlg. Data

**Riverview Pool**

**Location**

**J. G. McGEHEE.**

Scout Cards

Land Small Map

Land Wall Map

Tracings

France Map

Pierce Map

Misc.

MAR 21 1952


Drig. Data

County Ellis State Kansas  
 Sec. 20 (Blk. 11 (Sur. 18W Map No. 11 (Twp. 11 (Rge. 18W)

Operator C & G Drlg.

Well No. 1 Farm Wassinger

Elev. 2077 Location NE NW SE

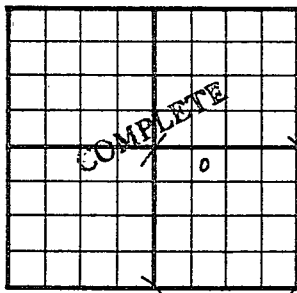

330 Ft. From N Line SE

990 Ft. From W Line Quarter

1st. Report

Completion JUL 9 1952

Remarks Riverview Pool

Spudding Date 3-21-52

Drlg. Data Oil well TD 3637

8" @ 211 Anhy 1377 Heeb. 3280

Tor. 3300 Lans. 3322 DST 3353-64

open  $\frac{1}{2}$  hr. Rec. 260' water 30' ocm

TD 3622 5" @ 3619 Arb. 3632 DD 3637

500 A S/ 70 bo 12 hr.

Comp. 25 bopd

J. G. McGEHEE

Scout Cards

Land Small Map

Land Wall Map

Tracings

France Map

Pierce Map

Misc.

JUL 16 1952

Drig. Data