


Ellis KANSAS

DX 78-1

Section 20 Township 11 Range 18 W

Well No. 1 Fred Nixon

Company Gulf Oil

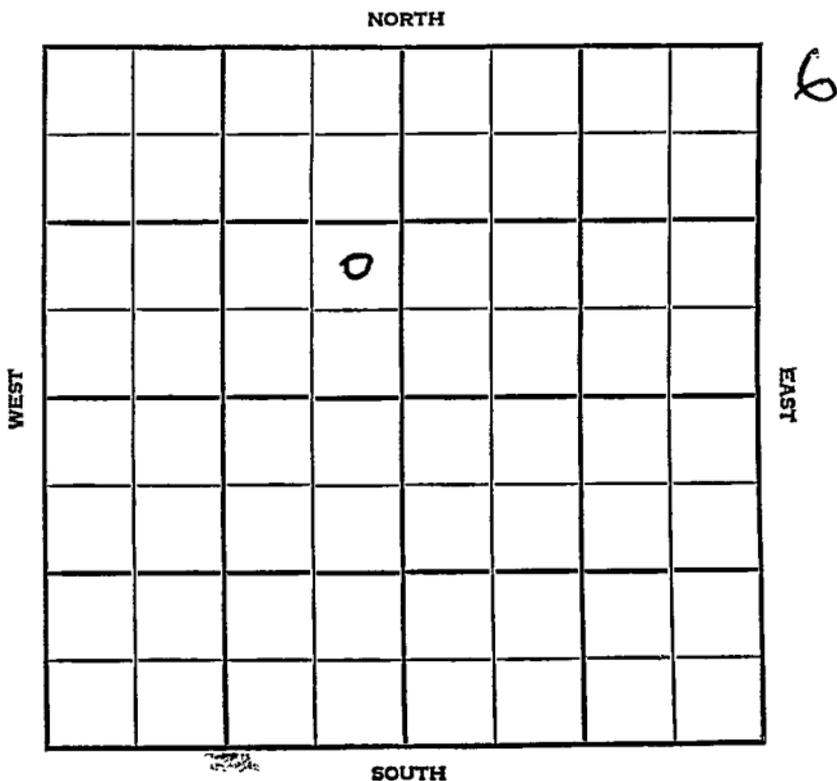

Ellis KANSAS

SEC.	TWP.	R.
20	11	18W

WELL NO. **1 Fred Nixon** FARM

COMPANY **Gulf Oil**

CONTRACTOR


Riverview Pool

_____ Ft. from N. Line

990 _____ Ft. from S. Line

330 _____ Ft. from E. Line

_____ Ft. from W. Line

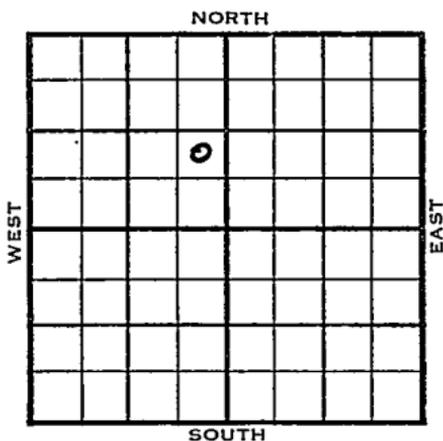

NE SE NW

1954	ELEVATION 1952'	REPORT
------	--------------------	--------

7/28

Location

8/18

Spud 7-31-54
 D&A
 TD 3601'
 8" @ 1260'
 Heeb 3176', Tor 3194', Lans 3218'
 DST 3256-87', opn 1 hr., rec. 135' SW,
 940#
 DST 3477-87', opn 1/2 hrs., rec. 7' mud,
 30#
 Simp. dol. 3571', Arb. 3589'
 DST 3591-3601', opn 1/2 hrs., rec. 380'
 SW, 880#
 TD 3601'
 D&A

ABANDONED

