


Section 20 Township 11 Range 18W

Well No. #2 Wasinger

Company C & G Drlg.

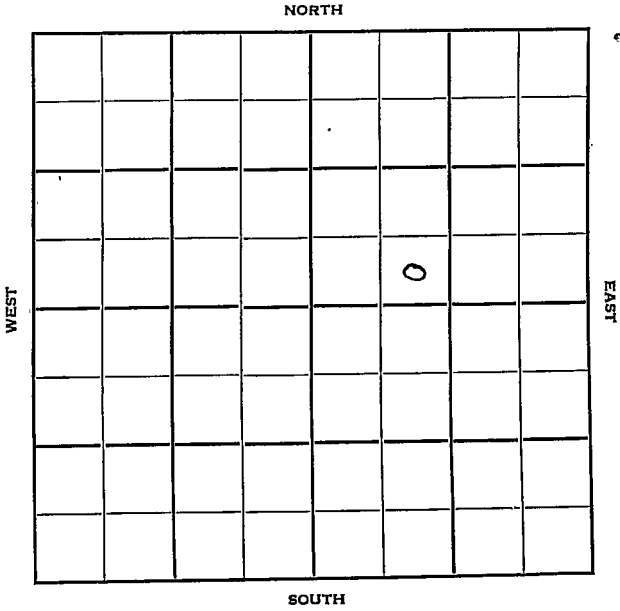

Sec. 20 Twp. 11 R. 18 W

Well No. # 2 Wasinger Farm

C & G Drlg. Company

Contractor


_____ Ft. from N. Line

330 _____ Ft. from S. Line

_____ Ft. from E. Line

990 _____ Ft. from W. Line

SE SW NE

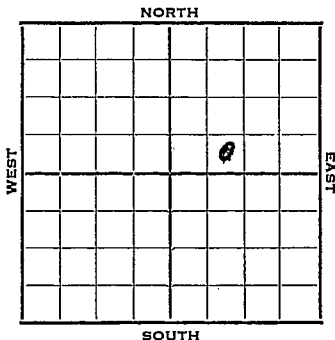

1952	Elev. 2068'	REPORT
9/24		Spud 9-23-52 8" @ 162 WOG
10/1		Anhy 1370, Topeka 3046 DST 3073-85 1/2 hr., 15' M 875# Drlg.
10/8		Heeb 3270, Toronto 3291, Lans 3311 DST 3342-49, 1 hr., 320' gas & 15' oil & 80' M&O:il Cong 3567', Simp 3583, Arb 3615 TD 3618 5" @ 3616'
10/15		CO to 3618, 500A S/3 BOPH Drlg. deeper 3622 TD 1000A S/11 BOPD, POP
10/22		NR
10/29		"
11/5		Spud 9-23-52 Oil Well TD 3622' 8" @ 162 Anhy 1370 Top. 3046 DST 3073-85 open 1/2 hr. rec. 15' mud 875# Heeb. 3270 Tor. 3291 Lans. 3311 DST 3342-49 open 1 hr. rec. 320' gas 158 oil 80' mud & oil Cong. 3567 Sim. 3583 Arb. 3615'

OVER

1952

11/5

TD 3618 ½ 5" @ 3616
CO to 3618 500 A S/ 3 boph
DD 3622 1000 A S/ 11 boph
Comp. 25 boph

COMPLETED

Count Cards	2070
1 and Small Map	
1 and Wall Map	3
Headings	
France Map	
Pierce Map	
Misc.	

SEP 26 1952

Orig. Data

County Ellis State Kansas

Sec. 20 (Blk. 11) (Sur. 18W) (Twp.) (Rge.) Map No.

Operator C & G Drlg.

Well No. 2 Farm Wasinger

Elev. 2068 Location SE SW NE

330 Ft. From S Line NE

990 Ft. From W Line Quarter

1st. Report

Completion NOV 5 1952

Remarks

Spudding Date 9-23-52

Drlg. Data Oil well TD 3622

8" @ 162 Anhy 1370 Top. 3046

DST 3073-85 open 1/2 hr. Rec. 15' mud

875# Heeb. 3270 Tor. 3291 Lans. 3311

DST 3342-49 open 1 hr. Rec. 320' gas

15' oil 80' mud & oil Cong. 35 67

Simp. 3583 Arb. 3615 TD 3618 5" @ 3616

CO to 3618 500 A S/.3 boph DD 3622

1000 A S/ 11' boph Comp. 25 bopd

J. G. McGEHEE

Scout Cards

Land Small Map

Land Walt Map

Tracings

France Map

Pierce Map

Misc.

NOV 27 1952