

Section 20 Township 11 Range 20W

Well No. #1 Phayer

Company Lindas Oil

NORTH

			0				

6

WEST

EAST

SOUTH

Ellis

Sec. 20 Twp. 11 R. 20W ✓

Well No. #1 Phayer Farm

Lindas Oil Company


Contractor

Ft. from N. Line

330 Ft. from S. Line

330 Ft. from E. Line

Ft. from W. Line

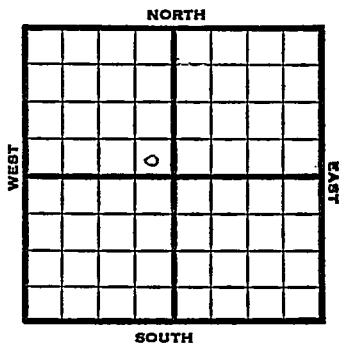

SE SE NW

Gulf farmout

1951 Elev. 2184' REPORT

10/31

Location

11/28

Spud 11-17-51

D&A TD 3900

8" @ 212'

Anhy 1635 Heeb. 3471

Ians. 3510 Cong. 3804

Simp. 3841

DST 3841-51 open 1 hr.

Rec. 55' wtr.

Arb. 3852-3900 TD

D&A

ABANDONED

County Ellis State Kansas

Sec. 20 (Blk.) 11 (Sur.) 20W Map No.

Operator Lindas Oil

Well No. 1 Farm Phayer

Elev. _____ Location SE SE NW

FIRST REPORT							
	0						

330 Ft. From S Line NW

330 Ft. From E Line Quarter

Ist. Report OCT 3 1951

Completion _____

Remarks Gulf farmout

Spudding Date _____

Drlg. Data _____

Location

J. E. TYRA

County Ellis State Kansas

Sec. 20 (Blk. Twp.) 11 (Sur. Rge.) 20W Map No.

Operator Lindas Oil

Well No. 1 Farm Phayer

Elev. 2184 Location SE SE NW

		0			
ABANDONED					

330 Ft. From S Line NW

330 Ft. From E Line Quarter

1st. Report NOV 28 1951

Completion

Remarks

Spudding Date 11-17-51.

Drilg. Data D & A TD 3900

8" @ 212 Anhy 1635 Heeb. 3471

Lans. 3510 Cong. 3804 Simp. 3841

DST 3841-51 open 1 hr. Rec. 55' water

Arb. 3852-3900 TD

D & A