

20

11

20W

SECTION _____ TOWNSHIP _____ RANGE _____

#1 Thayer

WELL NO. _____

Anschutz & Prime

COMPANY _____

NORTH

WEST

EAST

SOUTH

				.			
							.
							0
				.			

8

Ellis

KANSAS

SEC.	20	TWP.	11	R.	20W
------	----	------	----	----	-----

WELL NO. #1 Thayer

FARM

COMPANY Anschutz & Prime

CONTRACTOR Prime


Wildcat

_____ FT. FROM N. LINE

_____ FT. FROM S. LINE

_____ FT. FROM E. LINE

_____ FT. FROM W. LINE

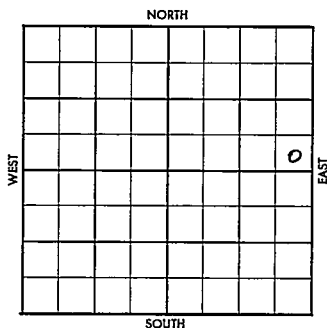

SE SE NE

	ELEVATION	REPORT
--	-----------	--------

1956

9-5

MIR

County Elk Elev. _____
 Sec. 20 Twp. 11 Rge. 20W
 Company Anschutz & Prime
 Farm Name Thayer No. 1

TOPS	DEPTH	LOG	DATUM
Anh.			
Tr.			
H.			
Tr.			
Dg.			
Bl.			
L.			
K.C.			
B.K.C.			
Ce.			
C.			
M.			
M.			
K.			
Mz.			
Mo.			
V.			
S.			
S.			
A.			
R.			
PE.			
G.			
T.D.			

Loc. in Sec. _____

SE SE NE

Geol. _____

Contr. _____

Prime

Pool _____

Wildcat

SEP 5 '55

FIRST REPORT

Date Comm. _____

M I R

200 2 453

200 2 453

County Ellis Elev. 213
 Sec. 20 Twp. 11 Rge. 20W
 Company Anschutz & Prime
 Farm Name Thayer No. 1

Co.

Loc.

No.

Sec.

T.

R.

TOPS	DEPTH	LOG	DATUM
Anb.	1570		
Tp.			
H.	3430		
Tr.	3453		
Dg.			
Bl.			
L.	3472		
K.C.			
B.K.C.	3685		
Ce.			
C. <u>cherty</u>	3789		
M.			
M.			
K.			
Mz.			
Me.			
V.			
S. <u>sh</u>	3828		
S.			
A.	3857		
R.			
PE.			
G.			
TD.	3895		

Loc. in Sec.

SE SE NE

Geol.

Contr.

Prime

P&G

Wildcat

SEP 12 '56

ABANDONED

Date Comm. C50 DHM-50110 Ac

M I R

SEP 12 '56

9-4-56 8578

321/200

3160

SEP 19 '56

Log.

D&A