



KANSAS

Ellis




Sec. 20 Twp. 11 R. 17W

Well No. #1 Hadley Farm

Gabert & Lindas Company

Bemis Pool

NORTH

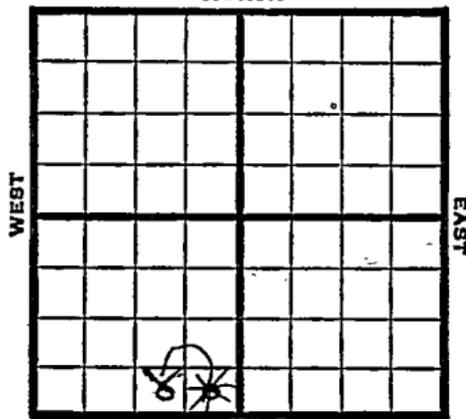

SOUTH

\_\_\_\_\_ Ft. from N. Line

330' \_\_\_\_\_ Ft. from S. Line

800' \_\_\_\_\_  
330' \_\_\_\_\_ Ft. from E. Line

\_\_\_\_\_ Ft. from W. Line

~~SE~~ ~~SW~~ CSL SE SW

1948 Eli 1923' REPORT

6/23 RUR  
6/29 8" @ 900'  
Drlg. 2666'  
7/8 Arb. 3438  
TD 3441'  
5" @ 3439'  
RUST  
7/14 48 shots 3448-62-2000 acid  
HFW SD  
TD 3465'  
7/21 TD 3465  
Arb. 3438'  
5" @ 3439'  
Aband.

**ABANDONED**

Map No. \_\_\_\_\_ Sec. 20 Twp. 11 R. 17W

Well No. 1 Hadley

Gabert & Lindas Company

FIRST REPORT Contractor

SE SW

SECTION PLAT

\_\_\_\_\_ Ft. from N. Line

330 Ft. from S. Line

330 Ft. from E. Line

\_\_\_\_\_ Ft. from W. Line


Ellis County

Location \_\_\_\_\_

Rig up \_\_\_\_\_

Drilling and Remarks:

R U R

RECORD

Cased \_\_\_\_\_ in., \_\_\_\_\_ ft.

Sand \_\_\_\_\_

Gas \_\_\_\_\_

Oil \_\_\_\_\_

Total Depth \_\_\_\_\_

PRODUCTION

1st 24 hrs. Nat. \_\_\_\_\_

1st 24 hrs. after shot \_\_\_\_\_

Gas \_\_\_\_\_ Cu. Ft.

Dry Hole \_\_\_\_\_

Abandoned \_\_\_\_\_

Date

JUN 23 1948 19

S. J. LEWIS Scout

Map No. 71 Sec. 20 Twp. 11 R. 17W

Well No. 1 Hadley

Gabert & Lindas Company

**CORRECTION**

Contractor

C S L SE SW

SECTION PLAT

\_\_\_\_\_ Ft. from N. Line

330 Ft. from S. Line

800 Ft. from E. Line

\_\_\_\_\_ Ft. from W. Line


Ellis County

Location \_\_\_\_\_

Rig up \_\_\_\_\_

Drilling and Remarks:

Reported

SE SW

RECORD.

Cased \_\_\_\_\_ in., \_\_\_\_\_ ft.

Sand \_\_\_\_\_

Gas \_\_\_\_\_

Oil \_\_\_\_\_

Total Depth \_\_\_\_\_

PRODUCTION

1st 24 hrs. Nat. \_\_\_\_\_

1st 24 hrs. after shot \_\_\_\_\_

Gas \_\_\_\_\_ Cu. Ft.

Dry Hole \_\_\_\_\_

Abandoned \_\_\_\_\_

Date

JUN 30 1948 19\_\_\_\_ S. J. LEWIS Scout

Map No. 71 Sec. 20 Twp. 11 R. 17WWell No. 1 HadleyGabert & Lindas Company**ABANDONED**

Contractor

C S L SE SW

E. I. 1923

SECTION PLAT

         Ft. from N. Line330 Ft. from S. Line800 Ft. from E. Line         Ft. from W. Line


Ellis County

Location         Rig up         

Drilling and Remarks:

cut 34385' @ 3439

## RECORD

Cased          in.,          ft.Sand         Gas         Oil         Total Depth 3465

## PRODUCTION

1st 24 hrs. Nat.         1st 24 hrs. after shot         Gas          Cu. Ft.Dry Hole         Abandoned         

Date

JUL 21 1948

19

S. J. LEWIS Scout