


ELLIS

KANSAS

SECTION 20 TOWNSHIP 11 RANGE 17W

WELL NO. #1 Hadley "E"

COMPANY Murfin Drlg.

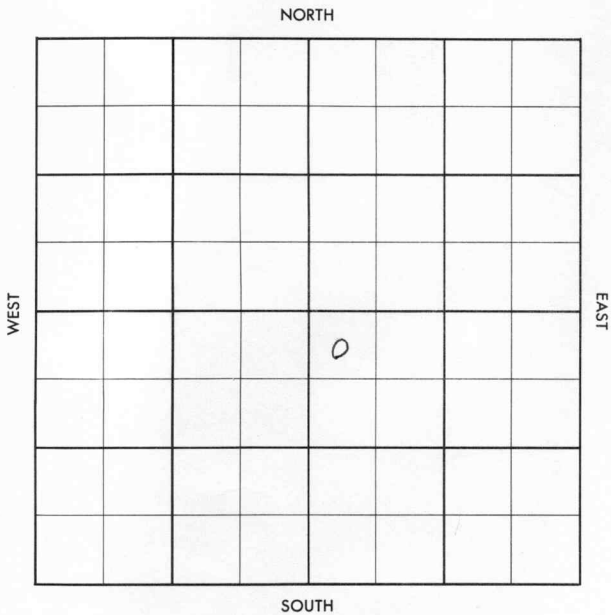

Ellis

KANSAS

SEC.	TWP.	R.
20	11	17W


WELL NO. #1 Hadley "E" FARM

COMPANY Murfin Drlg.

CONTRACTOR Co. Tools

Bemis-Shutts

\_\_\_\_\_ FT. FROM N. LINE  
 \_\_\_\_\_ FT. FROM S. LINE  
 \_\_\_\_\_ FT. FROM E. LINE  
 \_\_\_\_\_ FT. FROM W. LINE

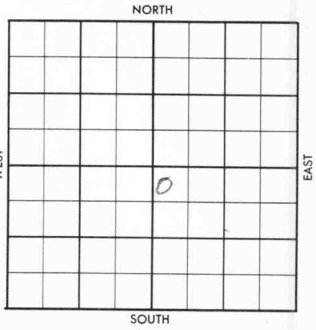

NW NW SE

	ELEVATION	REPORT
1956	1883'	

6-13 Comm. 6-8-56  
 Drlg. 2090

7-18 8 5/8" @ 861 w/130  
 DST 3016-50 op 30 min. rec. 15' mud,  
 BHP 860/20".  
 DST 3268-3317 op 30 min. rec. 10' mud,  
 BHP 0#.  
 DST 3408-22 op 1 hr, rec. 30' OCM,  
 BHP 700#.  
 5 1/2" @ 3416  
 CO 3435  
 S/ 50 BFPH, 20% oil, 8 hr.,  
 P/ 25 BOPD ≠ 200 BWPD.  
 Tp. 2837'; H. 3070'; L. 3115';  
 C. 3385'; Cg. sd. 3415';  
 TD 3435'

COMPLETED

County Elvis Elev. \_\_\_\_\_  
 Sec. 20 Twp. 11 Rgs. 17W  
 Company Murfin Drlg.  
 Farm Name Hadley "E" No. 1

TOPS	DEPTH	LOG	DATUM
Anh.			
Tp.			
H.			
Tr.			
Dg.			
B.L.			
L.			
K.C.			
B.K.C.			
Ce.			
C.			
M.			
M.			
K.			
Mz.			
Me.			
V.			
S.			
S.			
A.			
R.			
Pe.			
G.			
T.D.			

Loc. in Sec. NW NW SE

Geol. \_\_\_\_\_  
 Contr. \_\_\_\_\_  
 Co. tools \_\_\_\_\_  
 Pool BURNETT  
Bemis Phutts

FIRST REPORT  
 JUN 13 '56

Date Comm. 6-8-56  
drlg. 2090

JUN 1 2 1956

R.G.

Co.  
Lse.  
No.  
Sec.  
T.  
R.

Co.

County Elis Elev. 1883  
 Sec. 20 Twp. 11 Rgs. 17W  
 Company Mirfin Drl.  
 FarmName Hadley "E" No. 1

TOPS	DEPTH	LOG	DATUM
Anh.			
TP.	2837		
H.	3070		
Tr.			
Dg.			
BL.			
L.	3115		
K.C.			
B.K.C.			
Ce.			
C.	3385		
M- <u>cg sd</u>	3415		
M.			
K.			
Mz.			
Me.			
V.			
S.			
S.			
A.			
R.			
Pe.			
G.			
T.D.	3435		

Loc. in Sec. NW NW SE  
 Geol. \_\_\_\_\_  
 Contr. \_\_\_\_\_  
 Pool Burnett  
Bonic Shatts

COMPLETE	
JUL 18 1956	
	0

Sec.

No.

Sec.

T.

R.

Date Comm. 6-8-56  
drlc. 2090 JUN 20 '56 8 5/8 @ 861/130  
DST 3016-50 30" rec 15' M  
Md BHP 860/20 M 3265 JUN 27 '56  
DST 3268-3317 30" rec 10' Md  
(550) BHP 0 DST 3408-22 1hr  
rec 30' OCM BHP 700/ 5 1/2 @  
3416 JUL 3 '56 CO 3435 Frac JUL 11 '56  
JUL 18 '56 8 50 BFP 2090 oil 8 hrs  
P. 25 Bopd + 200 BW pd.