

Ellis


KANSAS

SECTION 20 TOWNSHIP 11 RANGE 17 W

WELL NO. #1 Hadley "B"

COMPANY Murfin Drlg.

NORTH

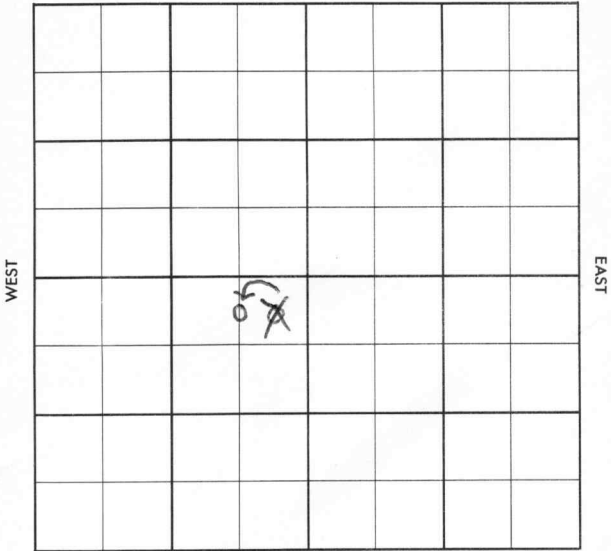

SOUTH

Ellis

KANSAS

SEC.	TWP.	R.
20	11	17W

WELL NO.

#1 Hadley B''

FARM

COMPANY

Murfin Drlg.

CONTRACTOR


Co. Tools

_____ Ft. from N. Line

_____ Ft. from S. Line

_____ Ft. from E. Line

_____ Ft. from W. Line

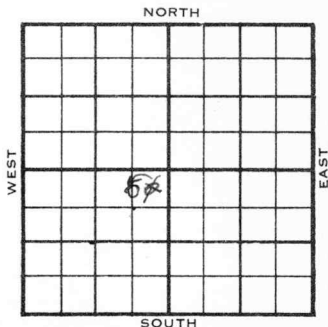

NE NE SW

c N 1/2 NE SW

	ELEVATION	REPORT
1955	1890 DF, 1892	KB
10/26	M I R	
1956		
1-5	Comm. 10-26-55 DST 3204 op 1 hr. rec. 245' wm, 1050 5 1/2" @ 3416 CO to 3445 S/ 5 boph 3 hrs. FU 2900' oil, 60' wtr. Comp. 53 bopd, 6% wtr. Anh. 1129 H. 3076 Tr. 3095 L. 3121 C. 3395 TD 3445'	

COMPLETED

CORRECTION

County Ellis Elev. _____
 Sec. 20 Twp. 11 Rge. 17W
 Company Murfin Drlg.
 Farm Name Hadley "B" No. 1

TOPS	DEPTH	LOG	DATUM	Loc. in Sec.
Anh.				C N $\frac{1}{2}$ NE SW
Tp.				
H.				
Tr.				
Dg.				
B.L.				
L.				
K.C.				Geol. _____
B.K.C.				Contr. _____
Ce.				
C.				
M.				
M.				Pool _____
K.				
Mz.				
Me.				
V.				
S.				
S.				
A				
R.				
Pe.				
G.				
T.D.				

CORRECTION

Date Comm. JAN 5 1956

Reported NE NE SW

Burnett

1890 DF

1892 KB

County Ellis

Elev.

Sec. 20Twp. 11Rge. 17WCompany Murfin Drlg.Farm Name Hadley "B"No. 1

TOPS

DEPTH

LOG

DATUM

Loc. in Sec.

C N $\frac{1}{2}$ NE SW

Anh.

Tp.

H.

Tr.

Dg.

B.L.

L.

K.C.

B.K.C.

Ce.

C.

M.

M.

K.

Mz.

Ma.

V.

S.

S.

A.

R.

P.E.

G.

T.D.

1129

3076

3095

3121

3395

3445

1184

1209

1229

1503

Geol.

Contr.

Co. tools

Pool

Burnett

COMPLETE

Date Comm. 10-26-55

JAN 5 1956

DST 3204 open 1 hr. rec. 245' wm

1050 5 $\frac{1}{2}$ " @ 3416 CO to 3445

S/ 5 boph 3 hr. FU 2900' oil 60' wtr.

Comp. 53 bopd 6% wtr.

Burnett Pool

. ○ ○

Use.

No.

Sec.

T.

२