

Ellis


KANSAS

SECTION 20 TOWNSHIP 11 RANGE 17 W

WELL NO. #2 Hadley "B"

COMPANY Murfin Drlg.

NORTH

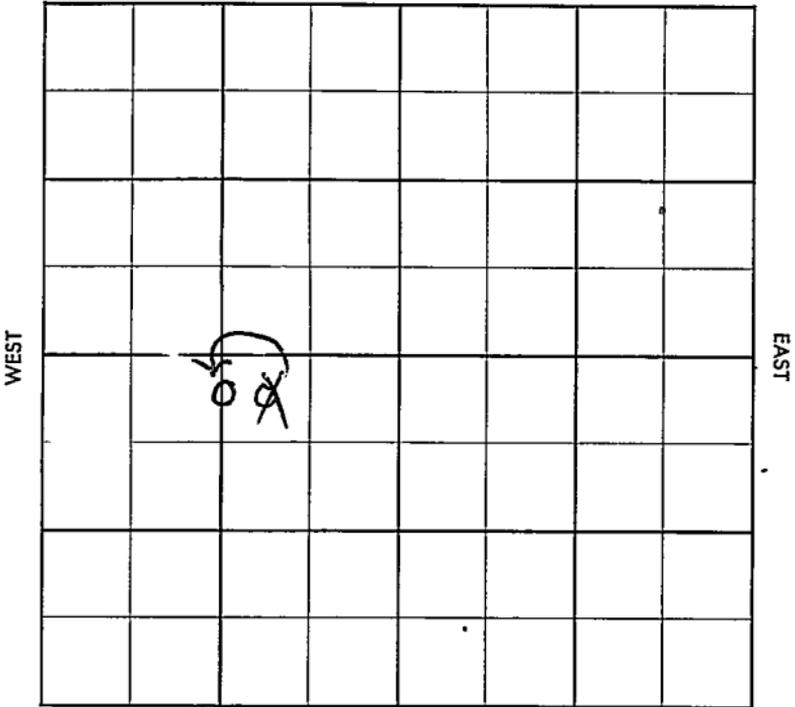

SOUTH

SEC.	20	TWP.	11	R.	17W
------	----	------	----	----	-----

WELL NO. #2 Hadley "B" FARM

COMPANY Murfin Drlg.

CONTRACTOR Co Tools


Bemis-Shutts

_____ Ft. from N. Line

_____ Ft. from S. Line

_____ Ft. from E. Line

_____ Ft. from W. Line

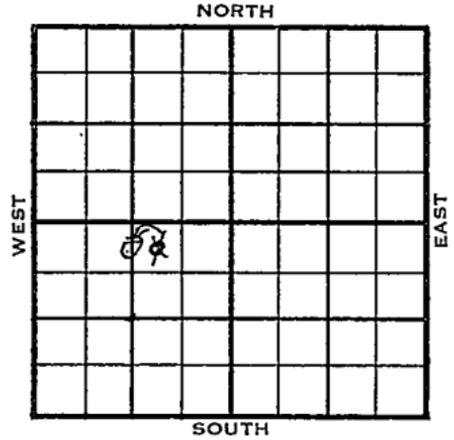

~~NW NE SW~~

N 1/2 N 1/2 SW

1955	ELEVATION	REPORT
	1882'	

11/9
Comm 11-6-55
8" @ 162
Drlg 800

1956

1-5 DST 3395-3425 op 1 hr. rec. 600' oil,
795/20"
5 1/2" @ 3406
CO to 3425
FU 500' oil
S/ 7 boph 1 hr.
FU 3200' oil
Comp. 50 bopd 6% wtr.
Tp. 2863
H. 3069
Tr. 3087
L. 3113
Chert 3384
TD 3425'

COMPLETED

County ELLS Elev. _____
 Sec. 20 Twp. 11 Rge. 17W
 Company Mirfin Drlg.
 Farm Name Hadley "B" No. 2

TOPS	DEPTH	LOG	DATUM
Anh.			
TP.			
H.			
Tr.			
Dg.			
BL.			
L.			
K.C.			
B.K.C.			
Ce.			
C.			
M.			
M.			
K.			
Mz.			
Mq.			
V.			
S.			
S.			
A.			
R.			
PE.			
G.			
T.D.			

Loc. in Sec. NW NE SW
 Geol. _____
 Contr. Co. tools
 Pool Bois-Sentis

FIRST REPORT
 NOV 9 55

Date Comm. 11-6-55
3" @ 162 drlg. 800

BARNETT

(Handwritten scribbles and a large checkmark-like mark)

Co.
Lse.
No.
Sec.
T.
R.

County Ellis Elev. 1882
 Sec. 20 Twp. 11 Rge. 17W
 Company Murfin Drlg.
 Farm Name Hadley "B" No. 2

TOPS	DEPTH	LOG	DATUM	Loc. in Sec.
Anb.				
Tp.	<u>2863</u>		<u>981</u>	<u>N$\frac{1}{2}$ N$\frac{1}{2}$ SW</u>
H.	<u>3069</u>		<u>1187</u>	
Tr.	<u>3087</u>		<u>1205</u>	
Dg.				
Bl.				
L.	<u>3119</u>		<u>1231</u>	
K.C.				Geol. _____
B.K.C.				Contr. _____
Ce.				
C. <u>chest</u>	<u>3384</u>		<u>1502</u>	<u>Co. tools</u>
M.				<u>Bummett</u>
M.				<u>Bemis-Shutts</u>
K.				
Mz.				
Mq.				
V.				
S.				
S.				
A.				
R.				
PE.				
G.				
TD.	<u>3425</u>			

COMPLETE

Date Comm. 11-6-55 JAN 5 1956
8" @ 162 DST 3395-3425 open 1 hr.
rec. 600' oil 795/20" 5 $\frac{1}{2}$ " @ 3406
CO to 3425 FU 500' oil S/ 7 boph 1 hr.
FU 3200' oil Comp. 50 bopd 6% wtr.

Co. No. Sec. T. R.