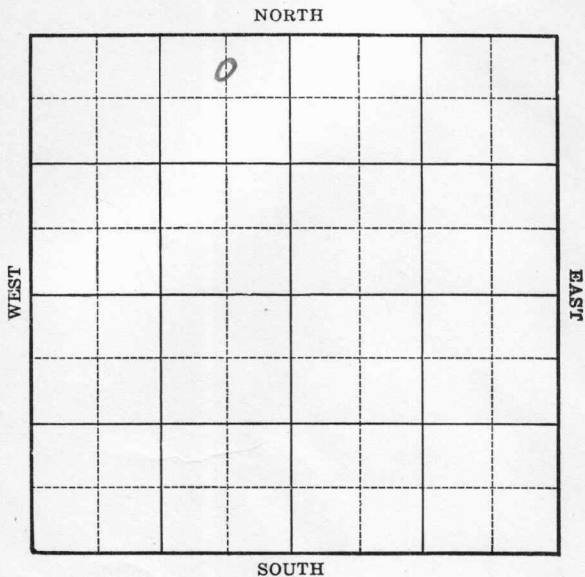


Section 20 Township 11 Range 17WWell No. #3 Hadley "D"Company Champlin Refining

Map No. 71 Sec. 20 Twp. 11 R. 17WWell No. 3 Hadley "D"
Champlin Refining Company


Contractor

FIRST REPORT

C N L NE NW

330 Ft. from N. Line Ft. from S. Line660 Ft. from E. Line Ft. from W. Line

SECTION PLAT

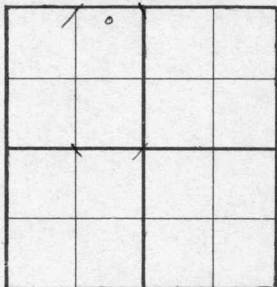

BEMIS POOL

Location Rig up

Drilling and Remarks:

Drlg. 700

RECORD

Cased in., ft.Sand Gas Oil Total Depth

PRODUCTION

1st 24 hrs. Nat. 1st 24 hrs. after shot Gas Cu. Ft.Dry Hole Abandoned

Date

OCT 16 1940 19

S. J. LEWIS

Scout

Map No. 71 Sec. 20 Twp. 11 R. 17WWell No. 3 Hadley "D"Champlin Refining Company

Contractor

COMPLETED

C N L NE NW

SECTION PLAT330 Ft. from N. Line Ft. from S. Line660 Ft. from E. Line Ft. from W. Line

Bemis pool

	0		

Location Rig up

Drilling and Remarks:

*Cu 43553**4" C3607**Cong. 3450**P. 3577**48 Sh. 53427-48**1500 acid**Pump. 50 lbs. Bk.***RECORD**Cased in., ft.Sand Gas Oil Total Depth 3697**PRODUCTION**1st 24 hrs. Nat. 1st 24 hrs. after shot Gas Cu. Ft.Dry Hole Abandoned

Date

NOV 13 1940

19

S. J. LEWIS

Scout