

KANSAS


Russell

FORM 51 5M 2-38 TPCO.

Section 20 Township 11 Range 15W

Well No. ~~#1~~ ^{#2} ~~#4~~ Bronson

Company Stanolind

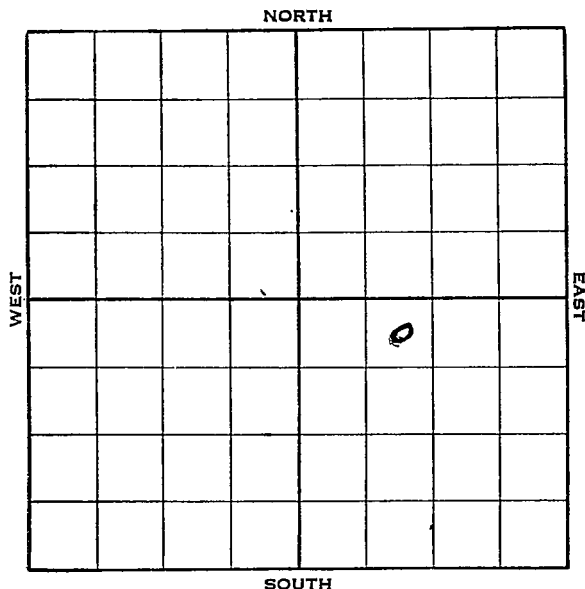

O.W.W.O.

KANSAS

Russell

Sec. 20 Twp. 11 R. 15-W

Sec. _____ Twp. _____ R. _____
Well No. #2 Bronson Farm

Stanolind

Company


330 Ft. from N. Line

Ft. from S. Line

Ft. from E. Line

990 Ft. from W. Line

Elev. 1842

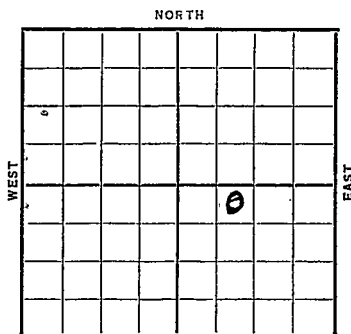

REPORT

Date _____

1938

8/3	Location
-----	----------

8/12	Cellar.
------	---------

8/19	B. C. R.
------	----------

8/26 16" - 65'. WOC.

9/2	12" - 460'. C. O. 599'.
-----	-------------------------

9/9	DrLg. 844'.
-----	-------------

9/16 Anhy & 10ⁿ - 930'. Dlg. 1855'.

9/23	8" - 2455'. Dig. 2497'.
------	-------------------------

9/30 8" - 2682'. S. O. 2690'.

DIg. 2694'..

10/7	Dodge 2925'. Lans. 2956'.
------	---------------------------

6" - 2960'. S.S.O. 2962-67'.

H.F.W. 3055-60'. T.D. 3087'.

U. R. 6".

10/14	Pay 3101-05' . 1200' oil.
-------	---------------------------

Swab 6 oil per hour 6 hrs.

7" - 3084'. T.D. 3106'. WOC.

OVER

1938

10/19 7" - 3084'.
Lans. 2956'.
T. D. 3106'.
2000 acid.
Pump 190 oil & 78 water.
Potential 570 bbls.

COMPLETED

O.W.W.O.

1950

7/19 Lans 2952 Arb 3330-39 TD
PB 3130 -----
36/3097-3106, 24/2989-95, 88/2870-92
4000 acid
Comp 16 bo 21 bwpd
Completed

FIRST REPORT
COMPLETED

Russell KANSAS

Map No. 72 Sec. 20 Twp. 11 R. 15WWell No. 4 BronsonStanolind Company

Contractor

FIRST REPORT

NE NW SE

330 Ft. from N. Line

_____ Ft. from S. Line

_____ Ft. from E. Line

990 Ft. from W. Line

SECTION PLAT

		0	

Location X

Rig up _____

Drilling and Remarks:

RECORD

Cased _____ in., _____ ft.

Sand _____

Gas _____

Oil _____

Total Depth _____

PRODUCTION

1st 24 hrs. Nat. _____

1st 24 hrs. after shot _____

Gas _____ Cu. Ft.

Dry Hole _____

Abandoned _____

Date

H. D. Hatfield

AUG 3 - 1938 19 Scout

Russell KANSAS

Map No. _____ Sec. 20 Twp. 11 R. 15WWell No. 4 BronsonStanolind

Company

Contractor

COMPLETED

NE NW SE

330 Ft. from N. Line

_____ Ft. from S. Line

_____ Ft. from E. Line

990 Ft. from W. Line**SECTION PLAT**

		o	

Location _____

Rig up _____

Drilling and Remarks:

*2000 acid**Pump 190 oil &
78 wtr**POT 570***RECORD**Cased 7 in., 3084 ft.Sand LENS 2956

Gas _____

Oil _____

Total Depth 3106**PRODUCTION**

1st 24 hrs. Nat. _____

1st 24 hrs. after shot _____

Gas _____ Cu. Ft.

Dry Hole _____

Abandoned _____

Date

OCT 19 193819E. D. Hatfield Scout

Kansas

OWWO


Map No. _____ Sec. 20 Twp. 11 R. 15WWell No. 2 BronsonStanolind Company_____
Contractor

NE NW SE

El. 1842
SECTION PLAT330 Ft. from N. Line

_____ Ft. from S. Line

_____ Ft. from E. Line

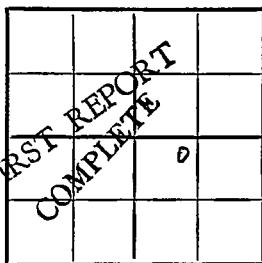990 Ft. from W. Line

Russell County

Location _____

Rig up _____

Drilling and Remarks:

Lans. 2952

Arb. 3330-39TD

PB 3130

36/ 3097-3106

24/ 2989-95

88/ 2870-92

4000 acid

RECORD

Cased _____ in., _____ ft.

Sand _____

Gas _____

Oil _____

Total Depth _____

PRODUCTION

1st 24 hrs. Nat. _____

1st 24 hrs. after shot _____

Gas _____ Cu. Ft.

Dry Hole _____

Abandoned _____

Comp. 16 bo 21 bwpd

Date

JUL 19 1950

19

J. E. TYRA Scout