


Section 20 Township 11 Range 15-W

Well No. 2 Durham

Company Liggett Oil

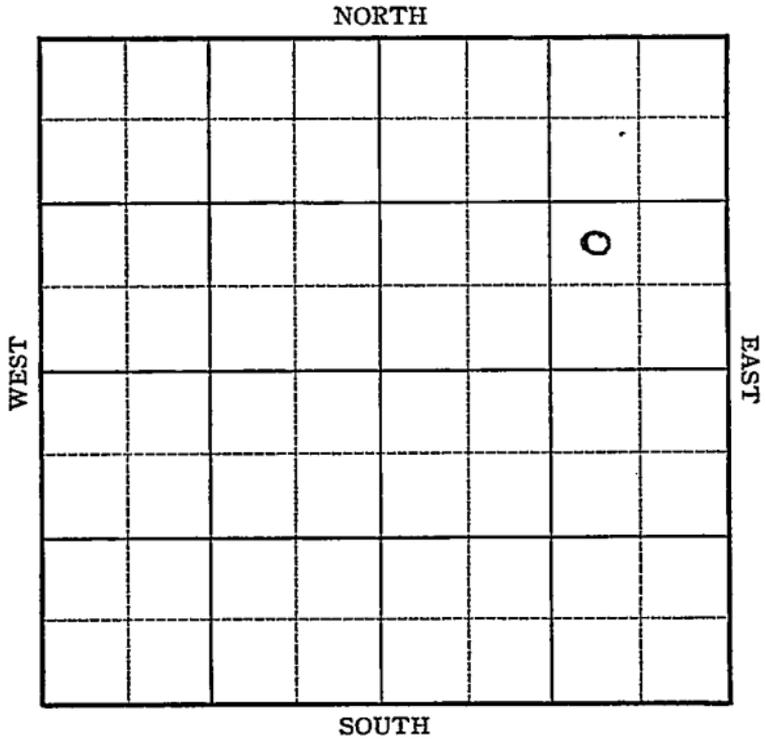

Sec. 20 Twp. 11 R. 15-W

Well No. #2 Durham Farm

Liggett Oil Company


 Ft. from N. Line

990 Ft. from S. Line

990 Ft. from E. Line

 Ft. from W. Line

Elev. 1854'

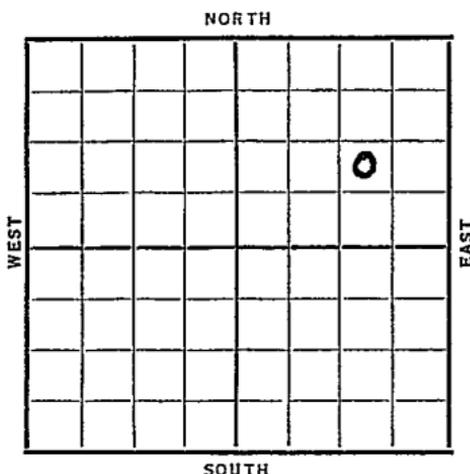

Date	REPORT
1938	
1/12	C. R.
1/20	"
1/28	"
2/4	15" - 357' Drlg. 485'
2/11	12" @ 580'. Anhy 934'.
	10" @ 936'. Drlg. 1285'.
2/18	Drlg. 2200'.
2/26	Drlg. 2200'.
3/4	8" @ 2671'. Drlg. 2680'.
3/11	K.C. 2956'. S.O. 2979'.
	7" @ 2985'. S.O. & G 2986-90'.
	1 BWPH 3000'. Drlg. 3042'.
3/18	7" @ 3086'. T.D. 3144' Fsg.
3/25	T.D. 3150'. 7" @ 3138'. WOG.
4/1	Drlg. 3185'. 700' oil.
4/8	T.D. 3200'. Cleaning out.
4/15	" " " " "
4/22	8000 acid. C.O. ^ ^
4/29	" " "
	" " "
	OVER

1938

5/4 7" @ 3138'.

K.C. 2956'.

T.D. 3200'.

8000 acid.

Potential 129 bbls.

COMPLETED .

Russell **KANSAS**

Map No. 72 Sec. 20 Twp. 11 R. 15W

Well No. 2 Durham

Liggett Oil Company

Contractor

FIRST REPORT

NW SE NE

_____ Ft. from N. Line

990 Ft. from S. Line

990 Ft. from E. Line

_____ Ft. from W. Line

SECTION PLAT

			0

Location _____

Rig up _____

Drilling and Remarks:

CR

RECORD

Cased _____ in., _____ ft.

Sand _____

Gas _____

Oil _____

Total Depth _____

PRODUCTION

1st 24 hrs. Nat. _____

1st 24 hrs. after shot _____

Gas _____ Cu. Ft.

Dry Hole _____

Abandoned _____

Date

JAN 12 1938 19

H. D. Hatfield Scout

Russell

KANSAS

Map No. 72 Sec. 20 Twp. 11 R. 15W

Well No. 2 Durham

Liggett Oil

Company

Contractor

COMPLETED

SECTION PLAT

NW SE NE

_____ Ft. from N. Line

990 Ft. from S. Line

990 Ft. from E. Line

_____ Ft. from W. Line

			0

Location _____

Rig up _____

Drilling and Remarks:

8000 acid

POT 129

RECORD

Cased 7 in. 3138 ft.

Sand K.C. 2956

Gas _____

Oil _____

Total Depth 3200

PRODUCTION

1st 24 hrs. Nat. _____

1st 24 hrs. after shot _____

Gas _____ Cu. Ft.

Dry Hole _____

Abandoned _____

Date

MAY 4 - 1938 19

H. D. Hatfield Scout