

15-051-21642

State Geological Survey  
**KANSAS DRILLERS LOG**  
 WICHITA BRANCH

API No. 15 — 051 — 21,642  
 County Number

Operator  
 ICER ADDIS

Address  
 Drawer 8038, Wichita, Kansas 67208

Well No. 1 Lease Name VEATCH


Footage Location  
 feet from (N) (S) line feet from (E) (W) line

Principal Contractor Geologist  
 Husky Drilling Co., Inc. Richard M. Foley

Spud Date Total Depth P.B.T.D.  
 March 6, 1979 3,725'

Date Completed Oil Purchaser  
 March 11, 1979 Dry Hole

S. 4 T. 11 R. 20 W  
 Loc. E/2 SE/4 NW/4  
 County Ellis

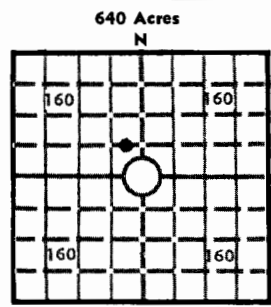

Locate well correctly  
 Elev.: Gr. 2,105'  
 DF KB 2,110'

**CASING RECORD** *Plugged and Abnd*

Report of all strings set — surface, intermediate, production, etc.

| Purpose of string | Size hole drilled | Size casing set (in O.D.) | Weight lbs/ft. | Setting depth | Type cement  | Sacks | Type and percent additives |
|-------------------|-------------------|---------------------------|----------------|---------------|--------------|-------|----------------------------|
| Surface           | 12-1/4"           | 8-5/8"                    | 20#            | 226           | 60-40 Pozmix | 150   | 2% Gel, 3% CaCh            |
|                   |                   |                           |                |               |              |       |                            |
**LINER RECORD**

**PERFORATION RECORD**

| Top, ft. | Bottom, ft. | Sacks cement | Shots per ft. | Size & type | Depth interval |
|----------|-------------|--------------|---------------|-------------|----------------|
|          |             |              |               |             |                |
|          |             |              |               |             |                |

**TUBING RECORD**

| Size | Setting depth | Packer set at |
|------|---------------|---------------|
|      |               |               |

**ACID, FRACTURE, SHOT, CEMENT SQUEEZE RECORD**

| Amount and kind of material used | Depth interval treated |
|----------------------------------|------------------------|
|                                  |                        |
|                                  |                        |
|                                  |                        |

**INITIAL PRODUCTION**

|  |   |
|--|---|
| Date of first production<br>Dry Hole               | Producing method (flowing, pumping, gas lift, etc.) |
| RATE OF PRODUCTION PER 24 HOURS                    | Oil Gas Water Gas-oil ratio<br>bbis. MCF bbis. CFPB |
| Disposition of gas (vented, used on lease or sold) | Producing interval (s)                              |

INSTRUCTIONS: As provided in KCC Rule 82-2-125, within 90 days after completion of a well, one completed copy of this Drillers Log shall be transmitted to the State Geological Survey of Kansas, 4150 Monroe Street, Wichita, Kansas 67209. Copies of this form are available from the Conservation Division, State Corporation Commission, 3830 So. Meridian (P.O. Box 17027), Wichita, Kansas 66217. Phone AC 316-522-2206. If confidential custody is desired, please note Rule 82-2-125. Drillers Logs will be on open file in the Oil and Gas Division, State Geological Survey of Kansas, Lawrence, Kansas 66044.

