

10-11-20W

File
PL

TYPE

AFFIDAVIT OF COMPLETION FORM

ACO-1 WELL HISTORY

Compt. _____

SIDE ONE

(Rules 82-3-130 and 82-3-107)

This form shall be filed with the Kansas Corporation Commission, 200 Colorado Derby Building, Wichita, Kansas 67202, within ninety (90) days after the completion of a well, regardless of how the well was completed.

State Geological Survey
WICHITA BRANCH

FOR INFORMATION REGARDING THE NUMBER OF COPIES TO BE FILED AND APPLICATIONS REQUIRING COPIES OF ACO-1 FORMS SEE PAGE TWO (2), SIDE TWO (2) OF THIS FORM.

F X Letter requesting confidentiality attached.

C _____ Attach ONE COPY of EACH wireline log run (i.e. electrical log, sonic log, gamma ray neutron log etc.)***Check here if NO logs were run X.

PLEASE FILL IN ALL INFORMATION. IF NOT AVAILABLE, INDICATE. IF INFORMATION LATER BECOMES AVAILABLE, SUBMIT BY LETTER.

LICENSE # 5151 EXPIRATION DATE June 1984

OPERATOR Gear Petroleum Company, Inc. API NO. 15-051-23,643

ADDRESS 300 Sutton Place COUNTY Ellis

Wichita, Kansas 67202 FIELD Wildcat

** CONTACT PERSON Jim Thatcher PROD. FORMATION N/A
PHONE 316-265-3351

PURCHASER N/A LEASE Harlin

ADDRESS _____ WELL NO. 1-10

WELL LOCATION N/2 NW/4 NW/4

DRILLING CONTRACTOR Red Tiger Drilling Company 330 Ft. from North Line and

ADDRESS 1720 KSB Building 660 Ft. from West Line of

Wichita, Kansas 67202 the NW (Qtr.) SEC 10 TWP 11S RGE 20W (W).

PLUGGING CONTRACTOR Allied Cementing Co., Inc.

ADDRESS Box 31, 332 West Wichita

Russell, Kansas 67665

TOTAL DEPTH 3,662' PBTD ---

SPUD DATE 11/6/83 DATE COMPLETED 11/14/83


ELEV: GR 2,007' DF --- KB 2,012'

DRILLED WITH (CABLE) (ROTARY) (AIR) TOOLS.

DOCKET NO. OF DISPOSAL OR REPRESSURING WELL BEING USED TO DISPOSE OF WATER FROM THIS LEASE ---

WELL PLAT

(Office Use Only)

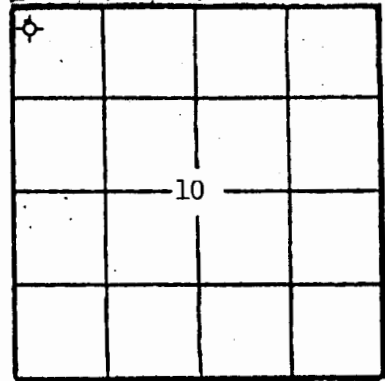

KCC _____
KGS

SWD/REP _____
PLG. _____

NGPA _____

Amount of surface pipe set and cemented 275.44' DV Tool Used? No

TYPE OF COMPLETION THIS AFFIDAVIT APPLIES TO: (Circle ONE) - Oil, Shut-in Gas, Gas, Dry, Disposal, Injection, Temporarily Abandoned. If OWWO, indicate type of re-completion _____. Other completion _____. NGPA filing _____.

ALL REQUIREMENTS OF THE STATUTES, RULES AND REGULATIONS PROMULGATED TO REGULATE THE OIL AND GAS INDUSTRY HAVE BEEN FULLY COMPLIED WITH.

A F F I D A V I T

Jim Thatcher, Drlg & Prod. Manager, being of lawful age, hereby certifies that: