

14-11-20W inc

SIDE ONE

STATE CORPORATION COMMISSION OF KANSAS
OIL & GAS CONSERVATION DIVISION
WELL COMPLETION OR RECOMPLETION FORM
ACO-1 WELL HISTORY
DESCRIPTION OF WELL AND LEASE

Operator: License # 4656
Name Davis Petroleum, Inc.
Address Route 1, Box 183-B
City/State/Zip Great Bend, KS 67530

Purchaser Inland Purchasing & Trans.
Wichita, Kansas

Operator Contact Person L.D. Davis
Phone 316-793-3051

Contractor: License # 5864
Name Lobo Drilling Co.

Wellsite Geologist Kim Shoemaker
Phone 316) 682-1537

Designate Type of Completion

New Well Re-Entry Workover
 Oil SWD Temp Abd
 Gas Inj Delayed Comp.
 Dry Other (Core, Water Supply etc.)

If OWNO: old well info as follows:

Operator
Well Name
Comp. Date Old Total Depth

WELL HISTORY

Drilling Method:

Mud Rotary Air Rotary Cable

6-24-87 7-1-87 7-7-87
Spud Date Date Reached TD Completion Date

3600'
Total Depth PBTD

Amount of Surface Pipe Set and Cemented at 265 feet
Multiple Stage Cementing Collar Used? Yes No
If yes, show depth set
If alternate 2 completion, cement circulated from 1750 feet depth to surf. w/ 350 SX cmt
Cement Company Name Allied Cementing Co.
Invoice # 787

API NO. 15-051-24,489

County Ellis

.NW. SW. SW... Sec. 14. Twp 11... Rge. 20. East
West

990 Ft North from Southeast Corner of Section

4950 Ft West from Southeast Corner of Section

(Note: Locate well in section plat below)


Lease Name Madden Well # 1

Field Name

Producing Formation Arbucle

Elevation: Ground 1995 KB 2000

Section Plat

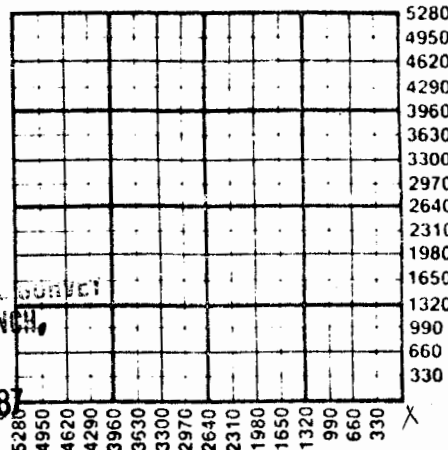

WATER SUPPLY INFORMATION

Disposition of Produced Water: Disposal
Docket # Repressuring

Questions on this portion of the ACO-1 call:

Water Resources Board (913) 296-3717

Source of Water:
Division of Water Resources Permit #

Groundwater... Ft North from Southeast Corner
(Well) ... Ft West from Southeast Corner of
Sec Twp Rge East West

Surface Water 990 Ft North from Southeast Corner
(Stream, pond etc) 5000 Ft West from Southeast Corner
Sec Twp Rge East West

Other (explain)
(purchased from city, R.W.D. #)

INSTRUCTIONS: This form shall be completed in triplicate and filed with the Kansas Corporation Commission, 200 Colorado Derby Building, Wichita, Kansas 67202, within 120 days of the spud date of any well. Rule 82-3-130, 82-3-107 and 82-3-106 apply. Information on side two of this form will be held confidential for a period of 12 months if requested in writing and submitted with the form. See rule 82-3-107 for confidentiality in excess of 12 months. One copy of all wireline logs and drillers time log shall be attached with this form. Submit OP-4 form with all plugged wells. Submit CP-111 form with all temporarily abandoned wells.

90282

W02-44-A

SIDE TWO

Operator Name Davis Petroleum, Inc. Lease Name Madden Well # 1

Sec 14 Twp 11 Rge 20 County Ellis

WELL LOG

INSTRUCTIONS: Show important tops and base of formations penetrated. Detail all cores. Report all drill stem tests giving interval tested, time tool open and closed, flowing and shut-in pressures, whether shut-in pressure reached static level, hydrostatic pressures, bottom hole temperature, fluid recovery, and flow rates if gas to surface during test. Attach extra sheet if more space is needed. Attach copy of log.

Drill Stem Tests Taken [X] Yes [] No
Samples Sent to Geological Survey [X] Yes [] No
Cores Taken [] Yes [X] No

Formation Description
[X] Log [] Sample

DST #1 3275-3305 Times: 20-20-45-45
Blow: 1st open: weak blow died
2nd open: flush tool got 3" blow
Recovery: 15' cgo, 60' hocm 20% oil
IFP: 53-57 FFP: 59-67 ISIP: 1053 FSIP: 1117
DST #2 3309-3355 Times: 45-45-45-45
Blow: off bb in 6 min.
Recovery: 600' gip, 900' cgo
IFP: 120-271 FFP: 319-373 ISIP: 1263
FSIP: 1234
DST #3 3353-3389 Times: 45-45-45-45
Blow: off bb in 5 min.
Recovery: 180' gip, 510' cgo, 150' ocw
IFP: 120-320 FFP: 361-440
ISIP: 981 FSIP: 975

Table with 3 columns: Name, Top, Bottom. Rows include Anhy, Topeka, Heebner, Toronto, Lansing, B K/C, Marmaton, Arbuckle, Log TD.

CASING RECORD [X] New [X] Used
Report all strings set-conductor, surface, intermediate, production, etc.
Table with columns: Purpose of String, Size Hole Drilled, Size Casing Set (In O.D.), Weight Lbs/Ft., Setting Depth, Type of Cement, #Sacks Used, Type and Percent Additives.
PERFORATION RECORD
Acid, Fracture, Shot, Cement Squeeze Record
TUBING RECORD Size 2 7/8 Set At 3596 Packer at Liner Run [] Yes [] No
Date of First Production July 8, 1987 Producing Method [] Flowing [X] Pumping [] Gas Lift [] Other (explain)

14-11-20W

SIDE TWO

Davis Petroleum, Inc.

Madden

1

Operator Name Lease Name..... Well #.....

Sec. 14 Twp. 11 Rge. 20 East West County Ellis

WELL LOG

INSTRUCTIONS: Show important tops and base of formations penetrated. Detail all cores. Report all drill stem tests giving interval tested, time tool open and closed, flowing and shut-in pressures, whether shut-in pressure reached static level, hydrostatic pressures, bottom hole temperature, fluid recovery, and flow rates if gas to surface during test. Attach extra sheet if more space is needed. Attach copy of log.

Drill Stem Tests Taken [X] Yes [] No
Samples Sent to Geological Survey [X] Yes [] No
Cores Taken [] Yes [X] No

Formation Description [] Log [] Sample

Name Top Bottom

DST #4 3402-3460 Times: 45-45-45-45
Blow: off bb in 3 min.
Recovery: 120' gip, 600' hocmw
IFP: 136-439 FFP: 510-637
ISIP: 1282 FSIP: 1263

DST #5 3432-3460 Times: 30-30-30-30
Blow: off bb in 3 min
Recovery 60' gip, 120' cgo, 300' hocmw
IFP: 140-290 FFP: 370-430
ISIP: 1215 FSIP: 1215

DST #6 3463-3479 Times: 20-20
Blow: weak blow died in 5 min.
Recovery: 15' Mud
IFP: 40-42 FFP: --- ISIP: 782 FSIP: ---

DST #7 3468-3521 Times: 20-20
Blow: weak blow died in 9 min.
Recovery: 10' mud
IFP: 69-71 FFP: -- ISIP: 465 FSIP: --

DST # 8 3594-3600 Times: 45-45-45-45
Blow: off bb in 7 min.
Recovery: 1400' oil
IFP: 138-316 FFP: 415-553
ISIP: 1166 FSIP: 1149

Table with 6 columns: Oil, Gas, Water, Gas-Oil Ratio, Gravity. Row 1: 50 Bbls, MCF, trace Bbls, CFPB. Includes 'Estimated Production Per 24 Hours' label.

METHOD OF COMPLETION

Production Interval

Disposition of gas: [] Vented [] Sold [] Used on Lease

[X] Open Hole [] Perforation [] Other (Specify)

[] Dually Completed

open hole
natural