


WELL LOG BUREAU—KANSAS GEOLOGICAL SOCIETY
503 East Murdock, Wichita, Kansas

Company— COPPINGER DRILG.C INC., ET AL
Farm Thayer No. 1

SEC. 17 T. 11 R.20W
C N $\frac{1}{2}$ NW NW

Total Depth 3650'
Comm. 2-18-57 3-4-57
Hot or Treated.
Contractor. Coppinger Drilg., Inc.
Issued. 3-30-57

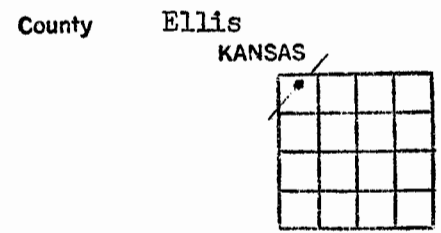

8 5/8" casing.
330' w/225 sx cem.

Elevation. 2021' DF

Production. Dry

Figure 1. Indicate Bottom of Formations.

sand	85
shale	490
shale-lime	600
shale	1005
sand	1150
shale	1230
shale-shells	1480
Anhydrite	1517
shale	1580
lime-shale	2140
lime	2210
lime-shale	2325
lime	2470
lime-shale	2490
shale	2755
shale-lime	2930
shale	3015
lime-shale	3260
lime	3544
lime-shale	3582
chert	3593
lime-chert	3621
chert	3627
lime-Arbuckle	3630
Arbuckle lime	3650
Total Depth RTD	

TOPS:

Anhydrite	1480
Topeka	3069
Heebner	3281
Toronto	3304
Lansing	3320
B/Kansas City	3532
Conglomerate	3582
Simpson	3608
Arbuckle	3626