

29-11-20 Wd
JUL 21 1986

STATE CORPORATION COMMISSION OF KANSAS
OIL & GAS CONSERVATION DIVISION
WELL COMPLETION OR RECOMPLETION FORM
ACO-1 WELL HISTORY
DESCRIPTION OF WELL AND LEASE

API NO. 15-..... 051-20537
County..... Ellis
W/2 SE SW 29 11 20 East
..... Sec..... Twp..... Rge..... X West

Operator: License # 5042
Name Edmiston Oil Co., Inc.
Address 1260 KSB Building
City/State/Zip Wichita, Kansas 67202

..... 660 Ft North from Southeast Corner of Section
..... 3630 Ft West from Southeast Corner of Section
(Note: Locate well in section plat below)

Purchaser..... Koch Oil Company
..... Box 2256, Wichita, KS 67201

Lease Name..... Rand Well #..... 1

Operator Contact Person..... Jon M. Callen
Phone..... (316) 265-5241

Field Name..... Nicholson

Contractor: License # 5042
Name F. K. Edmiston


Producing Formation..... Arbuckle

Wellsite Geologist..... Wyman Warren
Phone.....

Elevation: Ground..... 2232 2237 KB

Designate Type of Completion
 New Well Re-Entry Workover

Section Plat

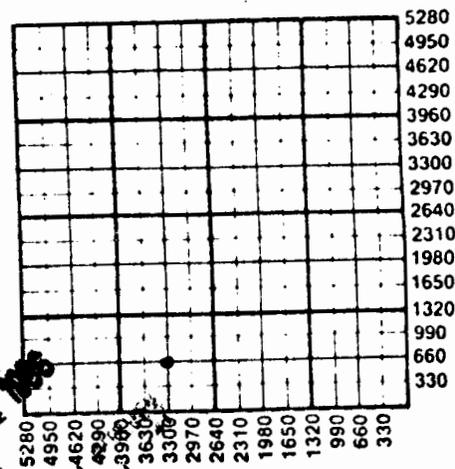

Oil SWD Temp Abd
 Gas Inj Delayed Comp.
 Dry Other (Core, Water Supply etc.)

If OWMO: old well info as follows:
Operator
Well Name
Comp. Date Old Total Depth.....

JUL 8 4 1986
WATER SUPPLY INFORMATION

Disposition of Produced Water: Disposal
Docket # 882 Repressuring

WELL HISTORY

Drilling Method:
 Mud Rotary Air Rotary Cable
11-20-69 11-30-69 12-10-69
.....
Spud Date Date Reached TD Completion Date
3852
.....
Total Depth PBTD

Questions on this portion of the ACO-1 call:
Water Resources Board (913) 296-3717
Source of Water:
Division of Water Resources Permit #.....

Amount of Surface Pipe Set and Cemented at 208 feet
Multiple Stage Cementing Collar Used? Yes No
If yes, show depth set..... feet
If alternate 2 completion, cement circulated
from..... feet depth to..... w/..... SX cmt
Cement Company Name
Invoice #

Groundwater..... Ft North from Southeast Corner
(Well) Ft West from Southeast Corner of
Sec Twp Rge East West
 Surface Water..... Ft North from Southeast Corner
(Stream, pond etc)..... Ft West from Southeast Corner
Sec Twp Rge East West
 Other (explain).....
(purchased from city, R.W.D. #)

INSTRUCTIONS: This form shall be completed in duplicate and filed with the Kansas Corporation Commission, 200 Colorado Derby Building, Wichita, Kansas 67202, within 90 days after completion or recompletion of any well. Rule 82-3-130 and 82-3-107 apply.
Information on side two of this form will be held confidential for a period of 12 months if requested in writing and submitted with the form. See rule 82-3-107 for confidentiality in excess of 12 months.
One copy of all wireline logs and drillers time log shall be attached with this form. Submit CP-4 form with

Operator Name Edmiston Oil Co., Inc. Lease Name Rand Well # 1

Sec. 29 Twp. 11 Rge. 20 East West County Ellis

WELL LOG

INSTRUCTIONS: Show important tops and base of formations penetrated. Detail all cores. Report all drill stem tests giving interval tested, time tool open and closed, flowing and shut-in pressures, whether shut-in pressure reached static level, hydrostatic pressures, bottom hole temperature, fluid recovery, and flow rates if gas to surface during test. Attach extra sheet if more space is needed. Attach copy of log.

Drill Stem Tests Taken Yes No
 Samples Sent to Geological Survey Yes No
 Cores Taken Yes No

Formation Description
 Log Sample

DST #1, 3817-48'. Open 1½ hrs.
 Rec. 150' oil cut mud. IBHP 343#/30 min.,
 FBHP 231#/30 min. FP 22-90#.
 DST #2, 3847-52'. Open 1 hr. Strong blow
 throughout. Rec. 550' oil, 170' oil cut
 mud, no wtr. IBHP 291#/30 min., FBHP
 291#/30 min., FP 291-291#.

Name Top Bottom

Sample Tops:

Anh. 1650 (+587)
 B/Anh. 1694 (+543)
 Heebner 3492 (-1255)
 Lansing 3530 (-1293)
 B/K. C. 3756 (-1519)
 Arbuckle 3845 (-1608)

Date of First Production 12-11-69	Producing Method <input type="checkbox"/> Flowing <input checked="" type="checkbox"/> Pumping <input type="checkbox"/> Gas Lift <input type="checkbox"/> Other (explain).....				
Estimated Production Per 24 Hours	Oil	Gas	Water	Gas-Oil Ratio	Gravity
	35 Bbls	MCF	Bbls	CFPB	

METHOD OF COMPLETION

Production Interval

Disposition of gas: Vented Open Hole Perforation Sold Other (Specify) 3848-52
 Used on Lease

Purpose of string	Size Hole Drilled	Size Casing Set (In O.D.)	Weight Lbs/Ft.	Setting Depth	Type of Cement	#Sacks Used	Type and Percent Additives
Surface	12-1/4	8-5/8"	28	208	Common	150	
Production		4-1/2"		3848	Pozmix	75	

PERFORATION RECORD

Acid, Fracture, Shot, Cement Squeeze Record

Shots Per Foot	Specify Footage of Each Interval Perforated	(Amount and Kind of Material Used)	Depth
	Open hole		

TUBING RECORD	Size	Set At	Packer at	Liner Run	<input type="checkbox"/> Yes <input type="checkbox"/> No
---------------	------	--------	-----------	-----------	--

29-11-20W
C W/2 SE SW

MAR 21 1970

DRILLER'S LOG

Elev. 2237' KB

COMPANY:

Edmiston Oil Company
425 First National Bank Building
Wichita, Kansas 67202

ROTARY DRILLING COMMENCED:

November 20, 1969

120 BOPD, NW
arb

ROTARY DRILLING COMPLETED:

December 1, 1969

WELL NAME:

RAND No. 1

LOCATION:

C W/2 SE SW Sec. 29-11S-20W
Ellis County, Kansas

CONTRACTOR:

E. K. Edmiston Drilling Co., Inc.
425 First National Bank Building
Wichita, Kansas 67202

CASING RECORD:


Set 208' of 8-5/8" surface pipe
w/150 sacks cement;
Ran 4 1/2" casing @ 3848' w/75 sacks

L O G

Measurements from top of Kelly Bushing (Elevation 2237 K.B.)


Sand and Shale	0 - 210
Shale and Shells	974
Sand and Shale	1600
Shale and Lime	1650
Anhydrite	1694
Red Bed and Shale	1900
Shale and Lime	2580
Lime	2680
Lime and Shale	3502
Lime	3852

Arbuck 3846

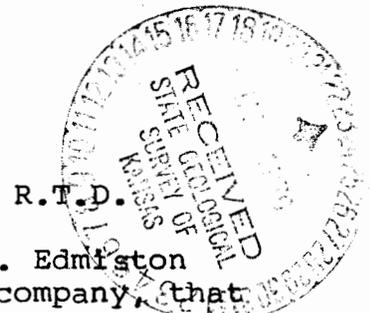

The undersigned, E. K. Edmiston, President of E. K. Edmiston Drilling Co., Inc., hereby certifies on behalf of said company, that the above log is a true and correct log of the formations encountered in drilling the above well, as reflected by the daily drilling reports.

E. K. Edmiston

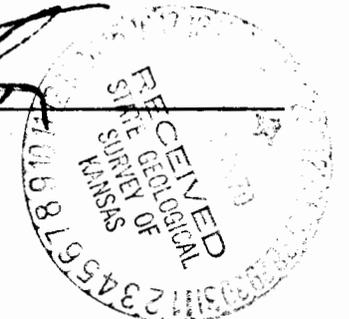

STATE OF KANSAS)
COUNTY OF SEDGWICK) SS:

BE IT REMEMBERED that on this 3rd day of December, 1969, before me, the undersigned, a Notary Public within and for the County and State aforesaid, came E. K. Edmiston, known to me to be the same person who executed the foregoing instrument on behalf of E. K. Edmiston Drilling Co., Inc., and he duly acknowledged the execution of the same for himself and for said company.