


Section 21 Township 11 Range 15W

Well No. 1 Reich "A" "B"

Company Aylward Drlg.

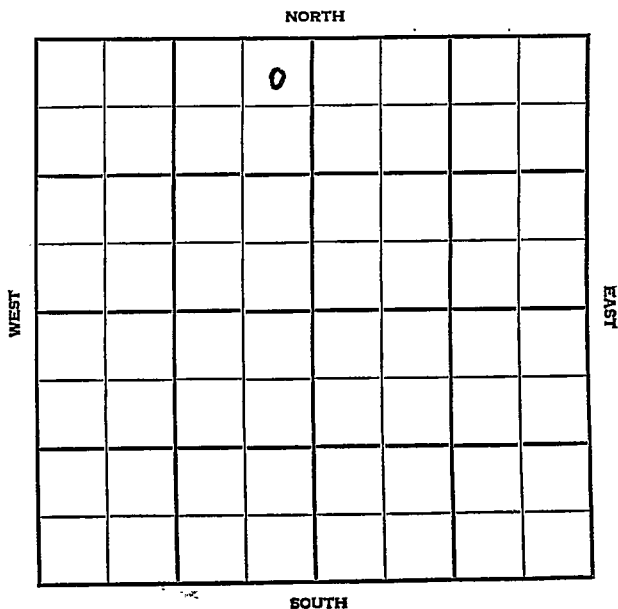

Russell KANSAS

SEC.	TWP.	R.
21	11	15 W
WELL NO.		
# Reich "A" "B"		
COMPANY		FARM
Aylward Drlg.		
CONTRACTOR		

Fairport Pool


330 \_\_\_\_\_ Ft. from N. Line

\_\_\_\_\_ Ft. from S. Line

330 \_\_\_\_\_ Ft. from E. Line

\_\_\_\_\_ Ft. from W. Line

NE NE NW

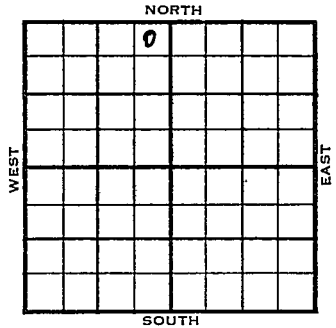

	ELEVATION	REPORT
1955	1898'	

1/26  
3/23

Location

Spud 2-5-55, Oil Well, TEL 3380  
 8" @ 115, KC 3009, Top 2704,  
 Heeb 2960, Tor 2279, Arb 3342,  
 TD 3380, 5" @ 3380, CO to 2379,  
 39/3361-78 500A S/2 BOPH  
 20/3345-50, SP 3355, 500A S/1 1/2  
 BOPH 2 hr. 20/3350-61 20/3342-  
 50 1500A S/2 1/2 BOPH SP 3040,  
 20/3010-18, 10 BO 16 hr, 500A,  
 S/30 BOPH  
 Comp. 25 BOPD

**COMPLETED**



## SCOUT TICKET

DX-201

Kansas

SEC.

TWP.

R.

21

11

15W

WELL NO.

1 Reich "B"

FARM

COMPANY

Aylward Drlg.

CONTRACTOR

CORRECTION

NE NE NW

330 FT. FROM N. LINE

. FT. FROM S. LINE

330 FT. FORM E. LINE

. FT. FROM W. LINE

			NORTH		
		0			
WEST					EAST
			SOUTH		

Russell County

LOCATION

RIG UP

DRILLING AND REMARKS:

Reported

#2 Reich "A"

RECORD

CASED IN., FT.

SAND

GAS

OIL

TOTAL DEPTH

1ST 24 HRS. NAT.

1ST 24 HRS. AFTER SHOT

GAS CU. FT.

DRY HOLE

ABANDONED

PRODUCTION

DATE

FEB 9 1955

SCOUT

FABEN GILSTRAP

County Russell State Kansas

Sec. 21 (Blk. 11) (Sur. 15W) Map No.

Operator Aylward Drlg.

Well No. 1 Farm Reich "B"

Elev. 1898 Location NE NE NW

		o			

330 Ft. From N Line NW

330 Ft. From E Line Quarter

Ist. Report

Completion MAR 23 1955

Remarks Fairport Pool

Spudding Date 2-5-55

Drlg. Data Oil well TD 3380

8" @ 115 KC 3009 Top. 2704

Heeb. 2960 Tor. 2979 Arb. 3342

TD 3380 5" @ 3380 CO to 2379

39/ 3361-78 500 A S/ 2 boph

20/ 3345-50 SP 3355 500-A S/ 1 1/2 boph

2 hr. 20/ 3350-61 20/ 3342-50

1500 A S/ 2 1/2 boph SP 3040 20/ 3010-18

10 bo 16 hr. 500 A S/ 30 boph

Comp. 25 boph

FABEN GILSTRAP