


Section 21 Township 11 Range 19W

Well No. #1 Sessin

Company Lion Oil

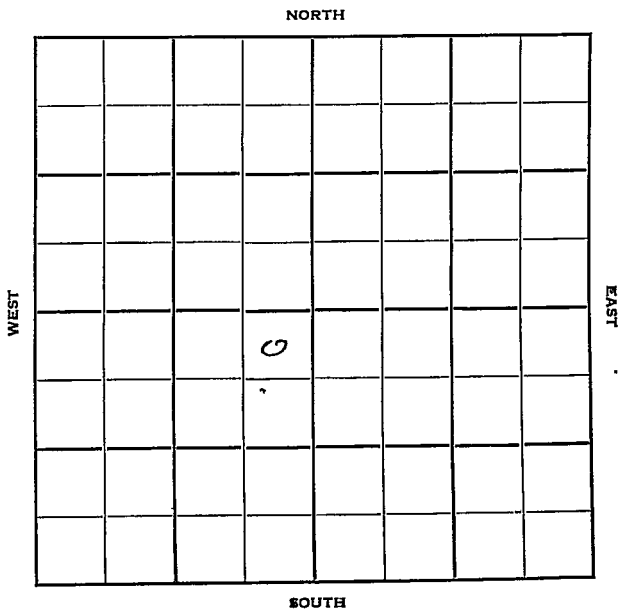

Ellis

KANSAS

Sec. 21 Twp. 11 R. 19W

Well No. #1 Sessin Farm

Lion Oil Company

Rine Contractor

Solomon - Semi Wildcat


330 Ft. from N. Line

Ft. from S. Line

330 Ft. from E. Line

Ft. from W. Line

NE NE SW

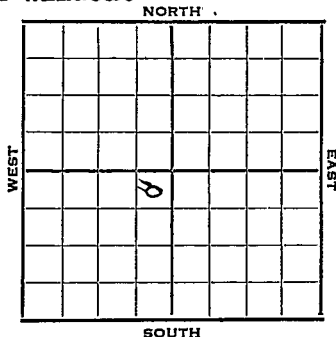

1952 Elev. 1959' REPORT

5/7 RUR

5/14 8" @ 253' Twist off 2881' Fishing

5/21 Spud 5-7-52

D&A TD 3575' 8" @ 253'

Top. 2951 Heeb. 3176

Lans. 3215 Cong. 3484

Simp. 3523 Arb. 3552

TD 3575 D&A

**ABANDONED**



