


Section 21 Township 11 Range 19W

Well No. #1 E. H. Solomon

Company Skelly

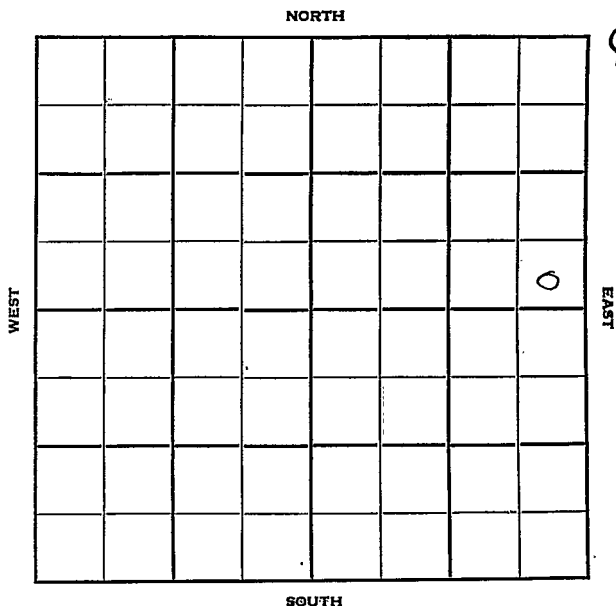


Ellis

KANSAS

Sec. 21 Twp. 11 R. 19WWell No. #1 E. H. Solomon FarmSkelly CompanySolomon Contractor Ft. from N. Line330 Ft. from S. Line330 Ft. from E. Line Ft. from W. Line

SE SE NE

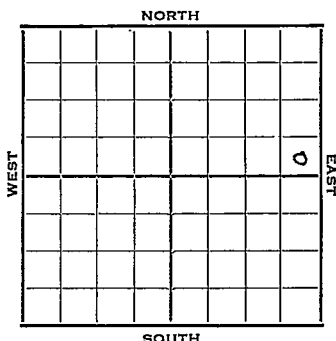

1952

Elev. 1974'

REPORT

3/5 Location

3/12 "

3/19 8" @ 291 WOC

3/25 Drlg. 3210'

4/1 Topeka 2964

Lans. 3197

Arb. 3500

5" @ 3501 WOC

Heeb. 3158

Simp. Sh 3470

RTD 3504

4/9 NR

4/23 Spud 3-14-52

Oil Well TD 3507' 8" @ 291'

Top. 2964 Heeb. 3158 Lans. 3197

Simp. 3470 Arb. 3500

TD 3504 5" @ 3501 DD 3507


B/ 1½ boph 10 hr. 200 A

P/ 68 bo 2 bw 15 hr. 500 A

P/ 24 bo 1% wtr. 1½ hr.

Comp. 195 bopd

COMPLETED

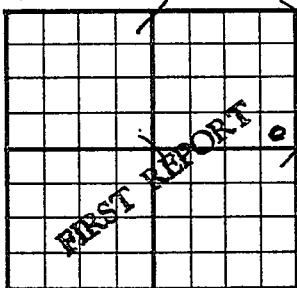County Ellis State KansasSec. 21 (Blk. 11 (Sur. 19W Map No. 11 (Twp. 11 (Rge. 19W)Operator SkellyWell No. 1 Farm E. H. SolomonElev. _____ Location SE SE NE330 Ft. From S Line NE330 Ft. From E Line Quarter1st. Report MAR 5 1952

Completion _____

Remarks _____

Spudding Date _____

Drilg. Data Solomon

Location _____


J. G. McGEHEE

County Ellis State Kansas
 Sec. 21 (Blk. 11) (Sur. 19W) Map No.

Operator Skelly Oil

Well No. 1 Farm E. H. Solomon

Elev. 1974 Location SE SE NE

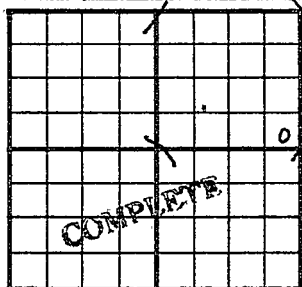

330 Ft. From S Line NE

330 Ft. From E Line Quarter

1st. Report

Completion APR 23 1957

Remarks Solomon Pool

Spudding Date 3-14-52

Drlg. Data Oil well TD 3507

8" @ 291 Top. 2964 Heeb. 3158

Lans. 3197 Simp. 3470 Arb. 3500

TD 3504 5" @ 3501 DD 3507 B/ 1 1/2 boph

10 hr. 200 A P/ 68 bo 2 bw 15 hr.

500 A P/ 24 bo 1% water 1 1/4 hr.

Comp. 195 bopd

J. G. McGEHEE