


Section 21 Township 11 Range 18W

Well No. #2 Wassinger "A"

Company Mid-States

Burnett Pool

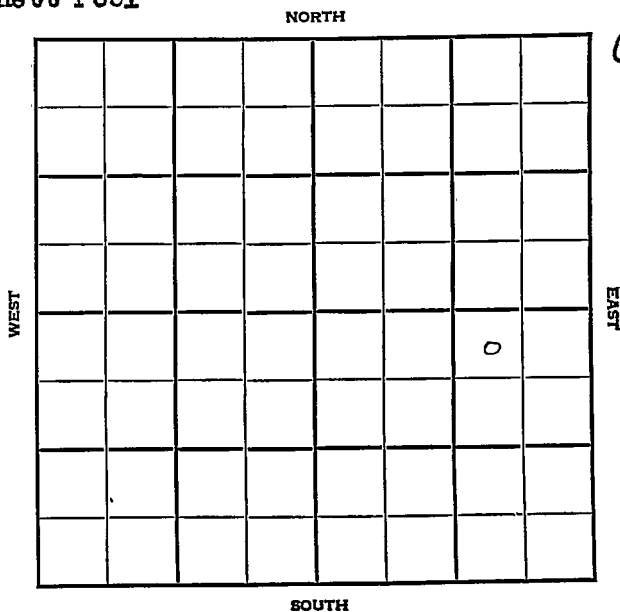

9

KANSAS

Ellis

Sec. 21 Twp. 11 R. 18W

Well No. #2 Wassinger "A" Farm

Mid-States Company

Burnett Pool


330' Ft. from N. Line

Ft. from S. Line

990' Ft. from E. Line

Ft. from W. Line

NW NE SE

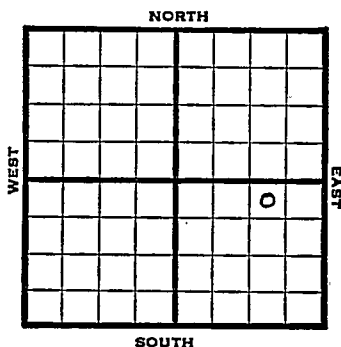

1948

Elev. 2071' REPORT

2/18

Location

2/25

"

3/3

Drlg. 1200'

3/10

10" @ 1338'
WOC

3/17

Drlg. 2235'

3/24

Drlg. 3385'

3/31

Lansing 3281'
Arbuckle 3592'
TD 3603'
5" @ 3597'
RUST

4/7

12 shots 3593-97'
500 acid
Swb. 101 bbls. oil 1 hr.

4/14

Arb. 3592'
5" @ 3597'
500 acid
Depth Pot 3000'
36.0 Gr.
TD 3603'
Comp.

COMPLETED

Map No. _____ Sec. 21 Twp. 11 R. 18^W

Well No. 2 Wassinger "A"

Mid-States

Company

FIRST REPORT

Contractor

NW NE SE

SECTION PLAT

330 Ft. from N. Line

Ft. from S. Line

990 Ft. from E. Line

Ft. from W. Line

			o

Ellis County

Location X

Rig up

Drilling and Remarks:

RECORD

Cased _____ in., _____ ft.

Sand _____

Gas _____

Oil _____

Total Depth _____

PRODUCTION

1st 24 hrs. Nat. _____

1st 24 hrs. after shot _____

Gas _____ Cu. Ft.

Dry Hole _____

Abandoned _____

Date

FEB 18 1948

19

S. J. LEWIS

Scout

Map No. 71 Sec. 21 Twp. 11 R. -18W

Well No. 2 Wasinger "A"

Mid-States Company

COMPLETE

NW NE SE

E. 2071
SECTION PLAT

			0

330 Ft. from N. Line

 Ft. from S. Line

990 Ft. from E. Line

 Ft. from W. Line

Ellis County

Location

Rig up

Drilling and Remarks:

Cur 73592
5" (73592)
5000 acid
Dep 73592 73000
860-84

RECORD

Cased in., ft.

Sand

Gas

Oil

Total Depth 3603

PRODUCTION

1st 24 hrs. Nat.

1st 24 hrs. after shot

Gas Cu. Ft.

Dry Hole

Abandoned

Date

APR 14 1948

19

S. J. LEWIS

Scout