


Section 21 Township 11 Range 18W

Well No. #1 Wasinger "A"

Company Mid-States

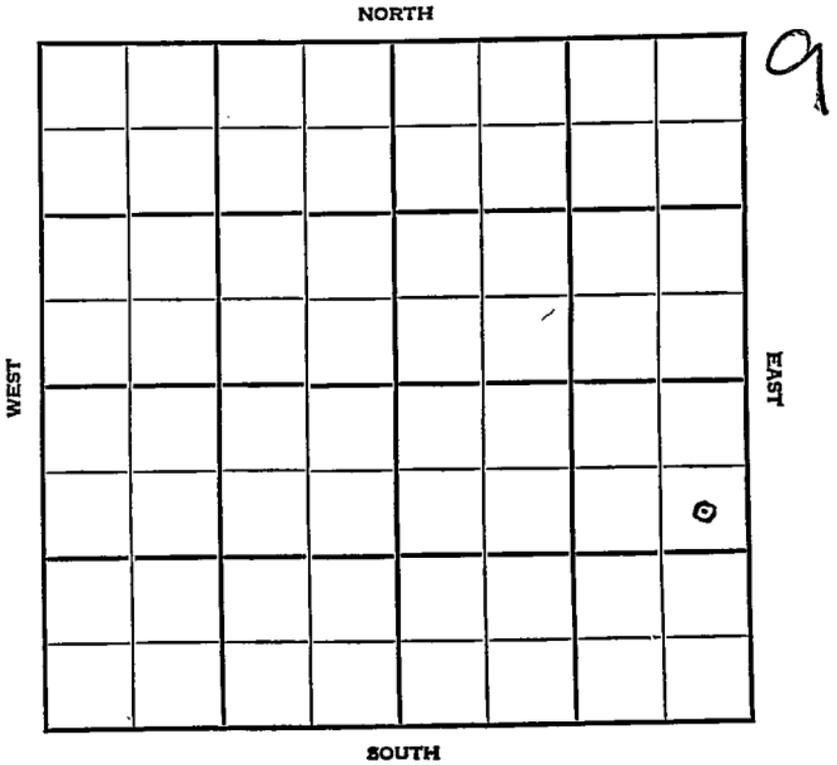

Sec. 21 Twp. 11 R. 18W

Well No. #1 Wasinger "A" Farm

Mid-States Company

Burnett


990 Ft. from N. Line

_____ Ft. from S. Line

330 Ft. from E. Line

_____ Ft. from W. Line

SE NE SE

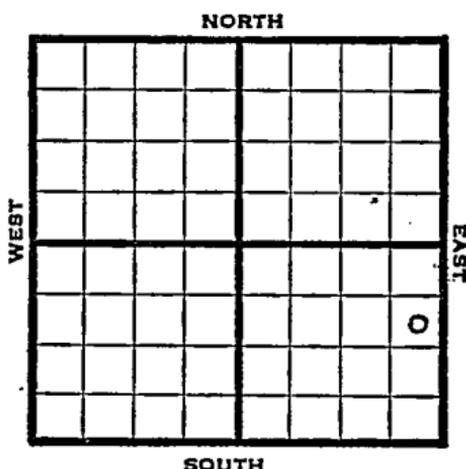

1948

Elev. 2075' REPORT

1/21 Surface hole.

2/26 10" @ 1345'
Drlg. 2045'

2/4 Drlg. 3315'

2/11 Lansing 3283'
BkG 3518'
Arbuckle 3589-92' TD
7" @ 3590'
RUST

2/18 TD 3595'
Swb 85 bbls oil PH 3 hrs.

2/25 Arb. 3589'
7" @ 3590'
250 Acid
Depth Pot 30000
36.0 Gr.
TD 3595'
Comp.

COMPLETED

Map No. _____ Sec. 21 Twp. 11 R. 18W

Well No. 1 Wasinger "A"

Mid-States Company

FIRST REPORT

Contractor

SE NE SE


SECTION PLAT

990 Ft. from N. Line

Ft. from S. Line

330 Ft. from E. Line

Ft. from W. Line

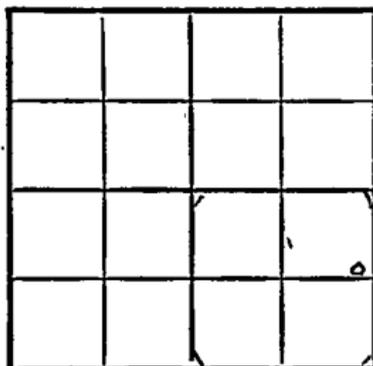

Ellis County

RECORD

Location _____

Cased _____ in., _____ ft.

Rig up _____

Sand _____

Drilling and Remarks:

Gas _____

Oil _____

surface hole

Total Depth _____

PRODUCTION

1st 24 hrs. Nat. _____

1st 24 hrs. after shot _____

Gas _____ Cu. Ft.

Dry Hole _____

Abandoned _____

Date

JAN 21 1948 19

S. I. LEWIS Scout

