
FORM 51 10M 8-47 Ellis KANSAS

Section 21 Township 11 Range 18W

Well No. #4 Wasinger "A"

Company Mid-States

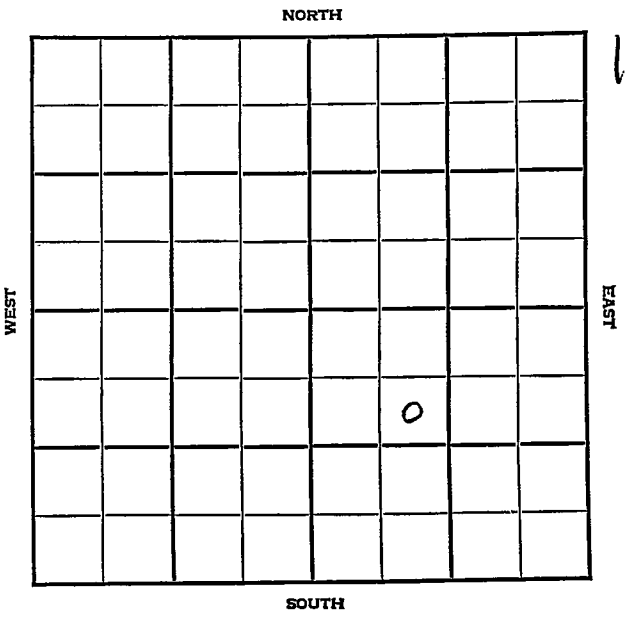

FORM 252-A
5M 4-48 PETROL

KANSAS Ellis

Sec. 21 Twp. 11 R. 18 W

Well No. #4 Wasinger "A" Farm

Mid-States Company

Burnett Pool


990' Ft. from N. Line

Ft. from S. Line

Ft. from E. Line

990' Ft. from W. Line

SE NW SE

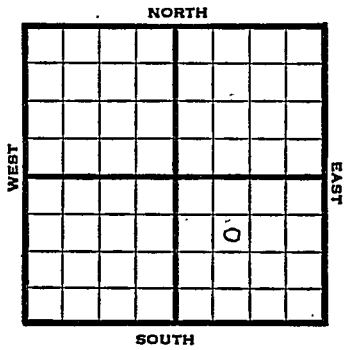

1948	REPORT Elev 2076'
5/12	RUR
5/19	10" @ 1352' Drlg. 1410'
5/26	Drlg. 2670'
6/1	Drlg. 3060'
6/9	Topeka 3015' Lansing 3294' Arbuckle 3598' TD 3604' 7"@ 3599' RUST
6/16	TD 3604' Arb. 3598' 7"@ 3599' 200 acid Echo Pot 3000 Oil 36 Gr. Comp COMPLETED

Form 26—200 Bks.—1-48—Palace

Kansas

Burnett Pool

Map No. _____ Sec. 21 Twp. 11 R. 18W


Well No. 4 Wasinger "A"

Mid-States Company

FIRST REPORT Contractor

SE NW SE

SECTION PLAT

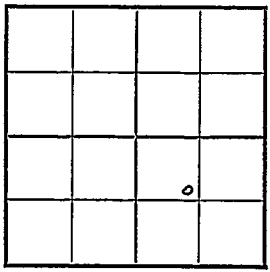

990 Ft. from N. Line

_____ Ft. from S. Line

_____ Ft. from E. Line

990 Ft. from W. Line

Ellis County

Location _____

Rig up _____

Drilling and Remarks:

R U R

RECORD

Cased _____ in., _____ ft.

Sand _____

Gas _____

Oil _____

Total Depth _____

PRODUCTION

1st 24 hrs. Nat. _____

1st 24 hrs. after shot _____

Gas _____ Cu. Ft.

Dry Hole _____

Abandoned _____

Date

MAY 1 2 1948 19____ S. J. LEWIS Scout

Form 26—200 Bks.—1-48—Palace

Burnett Pool

Kansas

Map No. 71 Sec. 21 Twp. 11 R. 18W

Well No. 4 Wasinger "A"


Mid-States Company

COMPLETE Contractor

SE NW SE

E.L. 2076

SECTION PLAT

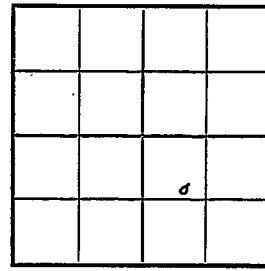

990 Ft. from N. Line

Ft. from S. Line

Ft. from E. Line

990 Ft. from W. Line

Ellis County

Location

Rig up

Drilling and Remarks:

Cr #3098

7" @3099

500 acid C

Echo Pt #3000

oil

36 ° Gr

RECORD

Cased in., ft.

Sand

Gas

Oil ✓

Total Depth 3604

PRODUCTION

1st 24 hrs. Nat.

1st 24 hrs. after shot

Gas Cu. Ft.

Dry Hole

Abandoned

Date

JUN 16 1948 19

S. J. LEWIS Scout