

KANSAS


Ellis

Section 21 Township 11 Range 18W

Well No. 8 Wasinger "A"

Company Mid-States

Burnett Pool
NORTH

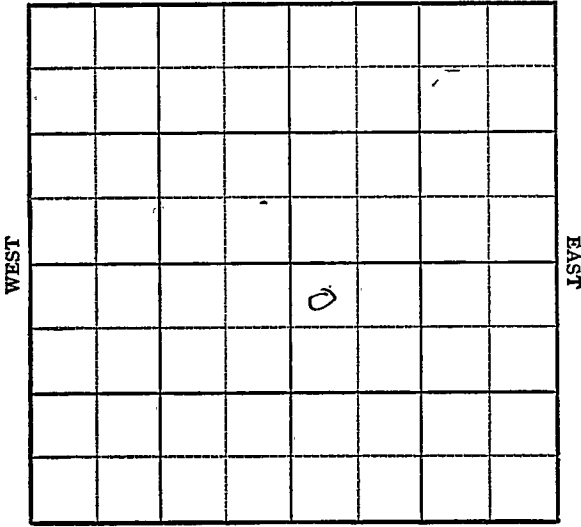

Handwritten: 14
10

SOUTH

KANSAS

Ellis

Sec. 21 Twp. 11 R. 18W

Well No. #8 Wasinger "A" Farm

Mid-States Company

Burnett Pool


350' Ft. from N. Line

_____ Ft. from S. Line

_____ Ft. from E. Line

330' Ft. from W. Line

NW SE

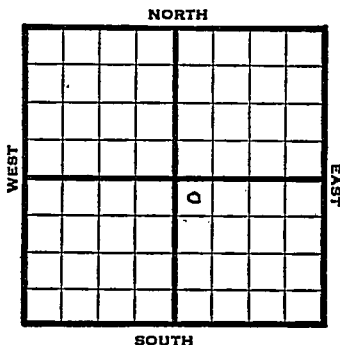

1948

Elev. 1988'

R E P O R T

9/8

RUR

9/14

8" @ 1265'

Drlg 1735'

9/21

Topeka 2937'

Drlg 3168'

9/29

Lansing 3209'

Arb. 3513-44'

TD 3544'

5" @ 3544'

10/6

96 shots 3514-30 2000 acid

Swb 55 bbls oil PH

10/13

Arb 3413'

5" @ 3544'

Perf.

2000 acid

Echo Pot. 3000 oil

Gr. 36°

TD 3544'

COMPLETED

Ellis County Kansas State

Map No. Sec. 21 Twp. 11 R. 18W

Well No. 8 Wasinger "A"

Mid-States Company

FIRST REPORT

Contractor

NW SE

SECTION PLAT

330 Ft. from N. Line

Ft. from S. Line

Ft. from E. Line

330 Ft. from W. Line

o

Burnett Pool

Remarks:

R U R

Date SEP 8 1948

Scout S. J. LEWIS

Map No. 71 Sec. 21 Twp. 11 R. 18W

Well No. 8 Wasinger "A"

Mid-States Company

COMPLETE

Contractor

E. J. 1988

SECTION PLAT

NW SE

330 Ft. from N. Line

_____ Ft. from S. Line

_____ Ft. from E. Line

330 Ft. from W. Line

		6	

Ellis County

RECORD

Location _____

Cased _____ in., _____ ft.

Rig up _____

Sand _____

Drilling and Remarks:

Gas _____

Oil

Total Depth 2544

CEL 3513

5" @ 3544

Perf.

2000 sand

Sc 10 Pa 43000 rll

36⁰ Se

PRODUCTION

1st 24 hrs. Nat. _____

1st 24 hrs. after shot _____

Gas _____ Cu. Ft.

Dry Hole _____

Abandoned _____

Date

OCT 13 1948

19

S. J. LEWIS

Scout