

Section 21 Township 11 Range 18W

Well No. 2 Wasinger

Company Cities Service

Burnett Pool

NORTH

			0				

WEST

EAST

SOUTH

11

Sec. 21 Twp. 11 R. 18-W ✓

Well No. #2 Wasinger Farm

Cities Service Company

Burnett


NORTH

330 Ft. from N. Line

_____ Ft. from S. Line

330 Ft. from E. Line

_____ Ft. from W. Line

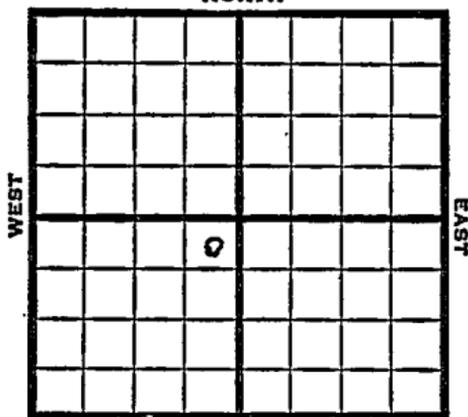

NE SW

SOUTH

1948 Elev. 2022' REPORT

11/3 Location

11/10 "

11/16 8" @ 129'

11/23 Drlg 1850'

11/30 Drlg 3525'

12/8 Lansing 3238'

Simp sand 3542'

Arb 3568'

TD 3570

5" @ 3569'

12/15 TD 3571

1000 acid

Pump 153 bbls oil 10 hrs.

12/22 Arb 3568'

5" @ 3569'

1000 acid

Pump 549 oil Pot.

Gr. 38°

TD 3571'

COMPLETED

Map No. _____ Sec. 21 Twp. 11 R. 18W

Well No. 2 Wasinger

_____ Cities Service _____ Company

_____ FIRST REPORT _____ Contractor

NE SW


SECTION PLAT

330 Ft. from N. Line

_____ Ft. from S. Line

330 Ft. from E. Line

_____ Ft. from W. Line

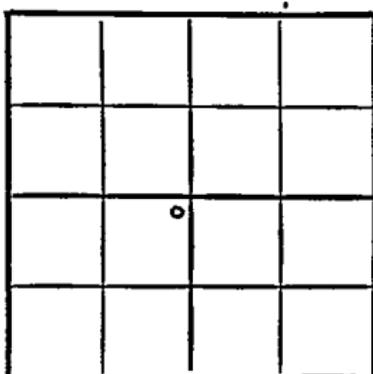

Ellis County

Location _____ X

Rig up _____

Drilling and Remarks:

RECORD

Cased _____ in., _____ ft.

Sand _____

Gas _____

Oil _____

Total Depth _____

PRODUCTION

1st 24 hrs. Nat. _____

1st 24 hrs. after shot _____

Gas _____ Cu. Ft.

Dry Hole _____

Abandoned _____

Date

NOV 3 1948 19

S. J. LEWIS Scout

Map No. 71 Sec. 21 Twp. 11 R. 18W

Well No. 2 Wasinger

Cities Service

Company

COMPLETE

Contractor

NE SW

E1, 2022

SECTION PLAT

330 Ft. from N. Line

_____ Ft. from S. Line

330 Ft. from E. Line

_____ Ft. from W. Line

	△		

Ellis County

Location _____

Rig up _____

Drilling and Remarks:

CR 83569
5" CR 83569
10000 cu ft
Pump 549 oil
PS
CR 83569

RECORD

Cased _____ in., _____ ft.

Sand _____

Gas _____

Oil _____

Total Depth 3571

PRODUCTION

1st 24 hrs. Nat. _____

1st 24 hrs. after shot _____

Gas _____ Cu. Ft.

Dry Hole _____

Abandoned _____

Date

DEC 22 1948

S. J. LEWIS

Scout