

Ellis

DX 78-1


KANSAS

Section 21 Township 11 Range 18W

Well No. #5 Wasinger

Company Cities Service

NORTH

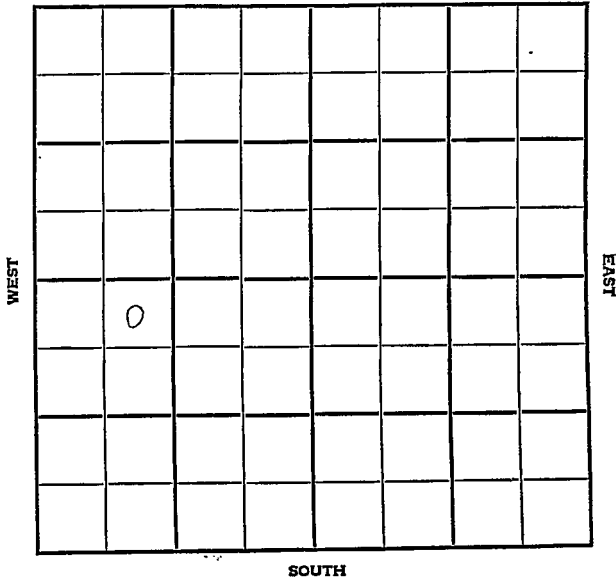

Ellis		KANSAS
SEC.	TWP.	R.
21	11	18 W
WELL NO.		
# 5 Wasinger		FARM
COMPANY		
Cities Service		
CONTRACTOR		


SW Burnett Pool

330 _____ Ft. from N. Line

_____ Ft. from S. Line

_____ Ft. from E. Line

990 _____ Ft. from W. Line

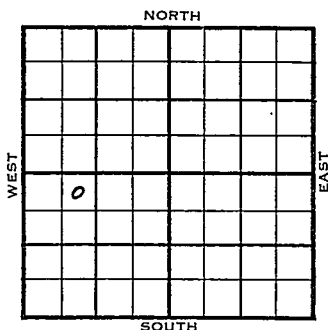

NE NW SW

	ELEVATION	REPORT
1954	1922'	


9/1 Location

9/29 Oil Well
 TD 3465'
 Anhy 1214'
 8" @ 1227'
 Top 2890', Heeb 3116', Dodge 3138'
 Lans 3159'
 DST 3215'-28' opn 1 hr, rec 7' Mud 40#
 DST 3250'-70' opn 1 hr, rec 435' mud &
 s.w. 1330# B KC 3385', Cong 3405'
 Simp sh. 3427', Simp sd 3430'
 Simp dolo 3433', Arb 3460'
 DST 3461'-65' opn 1 hr, rec 90' gas,
 181' g & mco 150' s.w. 670#
 TD 3465'
 5" @ 3461'
 CO to 3465'
 Comp 31 bopd 37 bw.

COMPLETED

FABEN GILSTRAP

County Ellis State Kansas
 Sec. 21 (Blk.) 11 (Sur.) 18W Map No.
 Operator Cities Service
 Well No. 5 Farm Wasinger
 Elev. 1922 Location NE NW SW

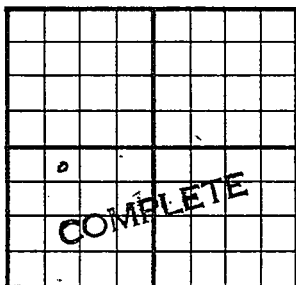

330 Ft. From N Line SW
990 Ft. From W Line Quarter

1st. Report Sep 1 1954

Completion SEP 29 1954

Remarks

Spudding Date

Drilg. Data Oil well TD 3465 SW Burnett Pool

Anhy 1214 8" @ 1227 Top. 2890

Heeb. 3116 Dodge 3138 Lans. 3159

DST 3215-28 open 1 hr. Rec. 7' mud

40# DST 3250-70 open 1 hr. Rec. 435'

mud & sw 1330# B KC 3385 Cong. 3405

Simp. sh. 3427 Simp. sd. 3430

Simp. dol. 3433 Arb. 3460 DST 3461-65

open 1 hr. Rec. 90' gas 181' g & mco

150' sw 670# - TD 3465 5" @ 3461

CO to 3465 Comp. 31 bopd 37 bw

FABEN GILSTRAP