


Section 21 Township 11 Range 18WWell No. 1 WasingerCompany Cities Service

Burnett Pool

NORTH

WEST

EAST

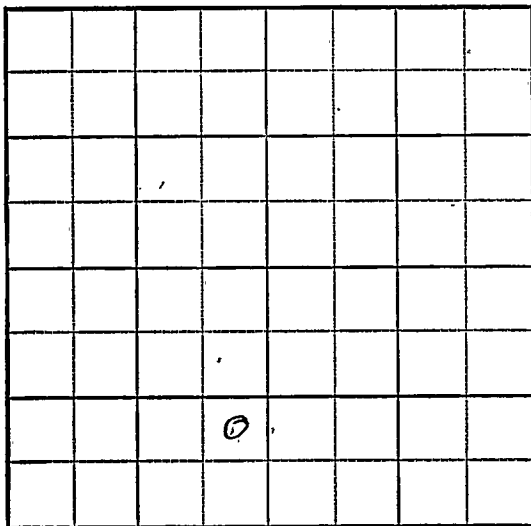

SOUTH

Sec. 21 Twp. 11 R. 18-W

Well No. #1 Wasinger Farm

Cities Service Company
Burnett


 Ft. from N. Line

990 Ft. from S. Line

330 Ft. from E. Line

 Ft. from W. Line

N E SE SW

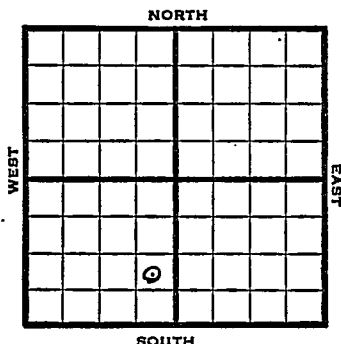

1948	Elev. 1980' REPORT
9/29	Location
10/6	Dr1g 1212'
10/13	8"@ 1270'
	rlg 2570'
10/19	Lansing 3200'
	Arb; 3522-24'
	TD 3524'
	5"@ 3523'
10/26	TD 3526
	Pump 40 bbls oil 10 hrs.
11/3	Arb 3522'
	5" @ 3523'
	1000 acid
	Pump 402 oil Pot.
	Gr. 36°
	TD 3526'

COMPLETED

Map No. _____ Sec. 21 Twp. 11 R. 18WWell No. 1 Wasinger

_____ Cities Service _____ Company

FIRST REPORT _____ Contractor

NE SE SW

SECTION PLAT

_____ Ft. from N. Line

990 Ft. from S. Line330 Ft. from E. Line

_____ Ft. from W. Line

Ellis County

Location X

Rig up _____

Drilling and Remarks:

RECORD

Cased _____ in., _____ ft.

Sand _____

Gas _____

Oil _____

Total Depth _____

PRODUCTION

1st 24 hrs. Nat. _____

1st 24 hrs. after shot _____

Gas _____ Cu. Ft.

Dry Hole _____

Abandoned _____

Date

SEP 29 1948 19 _____ S. J. LEWIS Scout

Map No. 71 Sec. 21 Twp. 11 R. 18W

Well No. 1 Wasinger

Cities Service

Company

COMPLETE

Contractor

NE SE SW

E. I. 1978
SECTION PLAT

 Ft. from N. Line

990 Ft. from S. Line

330 Ft. from E. Line

 Ft. from W. Line

	0		

Ellis County

RECORD

Location

Cased in., ft.

Rig up

Sand

Drilling and Remarks:

Gas

Oil

Total Depth 3526

PRODUCTION

1st 24 hrs. Nat.

1st 24 hrs. after shot

Gas Cu. Ft.

Dry Hole

Abandoned

Date

NOV 3 1948

19

S. J. LEWIS

Scout

Cr 3522
5" C 3523
1000 acid
Pump 402 oil 1000
36 2 1/2