

Section 21 Township 11 Range 18W

Well No. 3 Wasinger "A"

Company Cities Service

Burnett Pool

NORTH

14

WEST

EAST

0

SOUTH

KANSAS

Ellis

Sec. 21 Twp. 11 R. 18W

Well No. #3 Wasinger "A" Farm

Cities Service

Company

Burnett Pool


_____ Ft. from N. Line

330' Ft. from S. Line

330' Ft. from E. Line

_____ Ft. from W. Line

SE SW

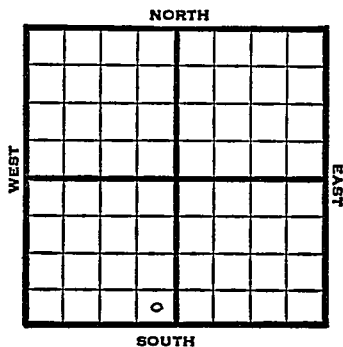

1949

Elev 2050' REPORT

1/5

Location

1/12

"

1/19

Drlg 1065'

1/26

8" @ 1290'

Drlg 2145'

2/2

Drlg. 3420'

2/9

Lansing 3253'

Simpson Sd 3550'

Arbuckle 3580-82'

TD 3582

5" @ 3581'

2/16

TD 3590'

320' oil 12 hrs.

2/23

TD 3594'

Arb. 3580'

5" @ 3587

1000 acid

P_{mp} 232 Oil Pot

38° Gr.

Comp

COMPLETED

Kansas

Burnett Pool

Map No. _____ Sec. 21 Twp. 11 R. 18WWell No. 3 Wasinger "A"

Cities Service _____ Company

FIRST REPORT Contractor

SE SW

SECTION PLAT

_____ Ft. from N. Line

330 Ft. from S. Line330 Ft. from E. Line

_____ Ft. from W. Line

Ellis County

Location _____ X

Rig up _____

Drilling and Remarks:

RECORD

Cased _____ in., _____ ft.

Sand _____

Gas _____

Oil _____

Total Depth _____

PRODUCTION

1st 24 hrs. Nat. _____

1st 24 hrs. after shot _____

Gas _____ Cu. Ft.

Dry Hole _____

Abandoned _____

Date

JAN 5 1949₁₉S. J. LEWIS Scout

Kansas

Map No. K71 Sec. 21 Twp. 11 R. 18WWell No. 3 Wasinger "A"

Cities Service Company

COMPLETE

Contractor

SE SW

E12050

SECTION FLAT

_____ Ft. from N. Line

330 Ft. from S. Line330 Ft. from E. Line

_____ Ft. from W. Line

Ellis County

Location _____

Rig up _____

Drilling and Remarks:

*Cor 12050**5" @ 3587**1000 acid**Pump 232 oil Prod**3580 ft*

RECORD

Cased _____ in., _____ ft.

Sand _____

Gas _____

Oil _____

Total Depth 2594

PRODUCTION

1st 24 hrs. Nat. _____

1st 24 hrs. after shot _____

Gas _____ Cu. Ft.

Dry Hole _____

Abandoned _____

Date

FEB 23 1949

19

S. J. LEWIS

Scout