


Section 21 Township 11N Range 18W

Well No. #5 Wasinger "A"

Company Mid-States

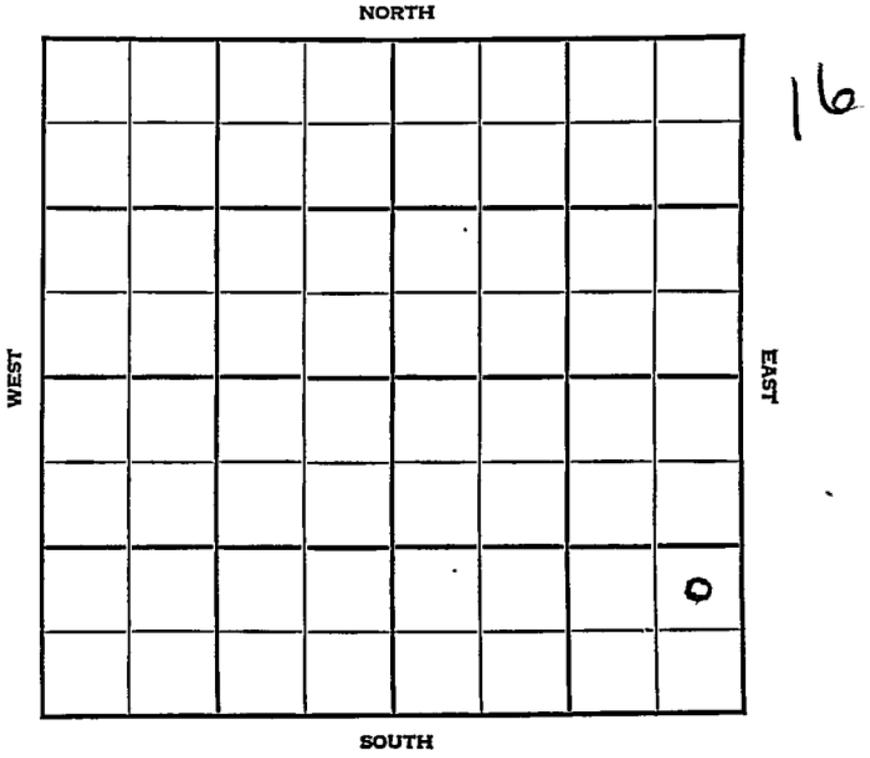

KANSAS

Ellis

Sec. 21 Twp. 11 R. 18W

Well No. #5 Wasinger "A" Farm

Mid-States Company

Burnett Pool


 Ft. from N. Line

990' Ft. from S. Line

330' Ft. from E. Line

 Ft. from W. Line

NE SE SE

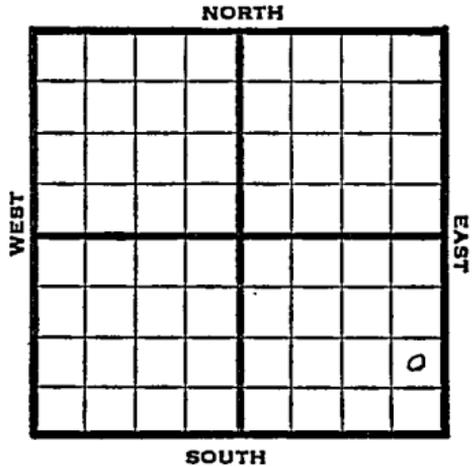

1948 Elev. 2071' REPORT

- 6/9 RUR
- 6/16 10" @ 1347'
Drlg. 2095'
- 6/23 Drlg 3245'
- 6/29 Lansing 3283'
BKC 3516'
Simpson 3564'
Arbuckle 3582½'
TD 3587'
7" @ 3582½'
- 7/8 Arbuckle 3582½'
7" @ 3582½'
250 Acid
Depth Pot 3000 oil
Gr. 38°
TD 3587'

COMPLETED

Map No. _____ Sec. 21 Twp. 11 R. 18W

Well No. 5 Wasinger "A"

Mid-States Company

FIRST REPORT

Contractor

NE SE SE

SECTION PLAT

			o

_____ Ft. from N. Line

990 Ft. from S. Line

330 Ft. from E. Line

_____ Ft. from W. Line

Ellis County

Location _____

Rig up _____

Drilling and Remarks:

R U R

RECORD

Cased _____ in., _____ ft.

Sand _____

Gas _____

Oil _____

Total Depth _____

PRODUCTION

1st 24 hrs. Nat. _____

1st 24 hrs. after shot _____

Gas _____ Cu. Ft.

Dry Hole _____

Abandoned _____

Date

JUN 9 1948

19

S. J. LEWIS

Scout

Map No. 71 Sec. 21 Twp. 11 R. 18W

Well No. 5 Wasinger "A"

Mid-States Company

COMPLETE Contractor

NE SE SE

E. 2071

SECTION PLAT

_____ Ft. from N. Line

990 Ft. from S. Line

330 Ft. from E. Line

_____ Ft. from W. Line

			0

Ellis County

Location _____

Rig up _____

Drilling and Remarks:

CR X 3052 1/2
7" @ 3052 1/2
2500 cu ft
Dep 1/2 @ 3000 oil
38-1/2

RECORD

Cased _____ in., _____ ft.

Sand _____

Gas _____

Oil *←* _____

Total Depth *3057* _____

PRODUCTION

1st 24 hrs. Nat. _____

1st 24 hrs. after shot _____

Gas _____ Cu. Ft.

Dry Hole _____

Abandoned _____

Date

JUL 8 1948 19

S. J. LEWIS Scout