
Ellis KANSAS

Form 51—5M—7-39—Palace

Section 21 Township 11 Range 17-W

Well No. #4 Bemis "A"

Company Republic

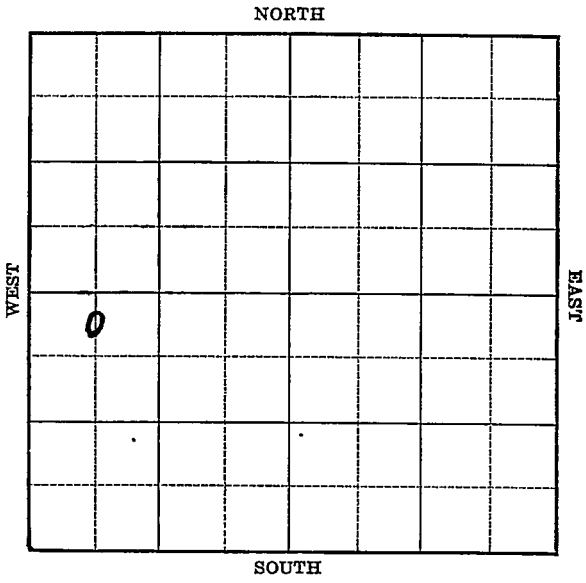

FORM 252-A 5M 2-40 KANSAS Ellis

Sec. 21 Twp. 11 R. 17-W

Well No. #4 Bemis "A" Farm

Republic Company


(Bemis)

330 Ft. from N. Line

Ft. from S. Line

Ft. from E. Line

660 Ft. from W. Line

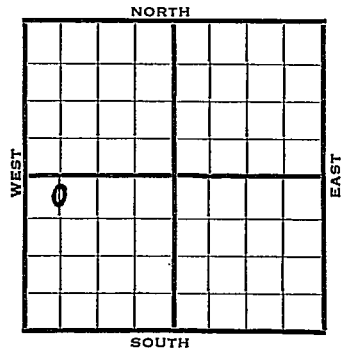

Elev. 1949

1940	REPORT
4/3	Location
4/12	C & P.
4/18	"
4/25	Surface hole.
5/2	8" - 78' Anhy 1160'
	Drlg. 2535'
5/9	Lansing 3170' Drlg. 3330'
5/16	Arb. 3468' 5" - 3468'
	T.D. 3474' RUST.
5/23	T.D. 3477' 3000' oil 2 hours.
5/29	Arb. 3468'
	5" - 3468'
	T.D. 3477'
	Depthograph potential 5126 bbls.
	Maximum 3000 bbls.
	COMPLETED

Form 26—200 Bks.—1-40—Palace Ellis KANSAS

Map No. 71 Sec. 21 Twp. 11 R. 17W

Well No. 4 Bemis "A"

Republic Company

Contractor

FIRST REPORT

C N L NW SW

330 Ft. from N. Line


_____ Ft. from S. Line

_____ Ft. from E. Line

660 Ft. from W. Line

BEMIS POOL

SECTION PLAT

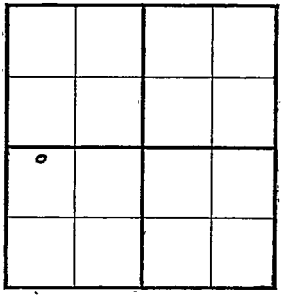

Location X

Rig up

Drilling and Remarks:

RECORD

Cased _____ in., _____ ft.

Sand

Gas

Oil

Total Depth

PRODUCTION

1st 24 hrs. Nat.

1st 24 hrs. after shot

Gas _____ Cu. Ft.

Dry Hole

Abandoned

Date

APR 3 1940

S. J. LEWIS Scout

Form 26—200 Bks.—1-40—Palace Ellis KANSAS

Map No. 71 Sec. 21 Twp. 11 R. 17W

Well No. 4 Bemis "A"

Republic Natural Gas Company

Contractor

COMPLETED

C N L NW SW

330 Ft. from N. Line


_____ Ft. from S. Line

_____ Ft. from E. Line

660 Ft. from W. Line

BEMIS POOL

SECTION PLAT

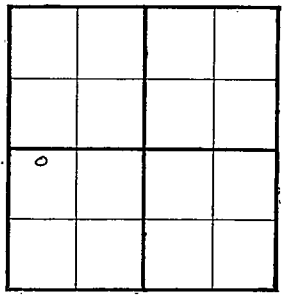

Location _____

Rig up _____

Drilling and Remarks:

Ac f 3468
5" C 3468.
Depthograph Rd
5126

Maximum 3000

RECORD

Cased _____ in., _____ ft.

Sand _____

Gas _____

Oil _____

Total Depth 3477

PRODUCTION

1st 24 hrs. Nat. _____

1st 24 hrs. after shot _____

Gas _____ Cu. Ft.

Dry Hole _____

Abandoned _____

Date

MAY 29 1940 19

S. J. LEWIS Scout