


Section 21 Township 11 Range 17-W

Well Number #2 Bemis "C"

Company Ryan Consolidated

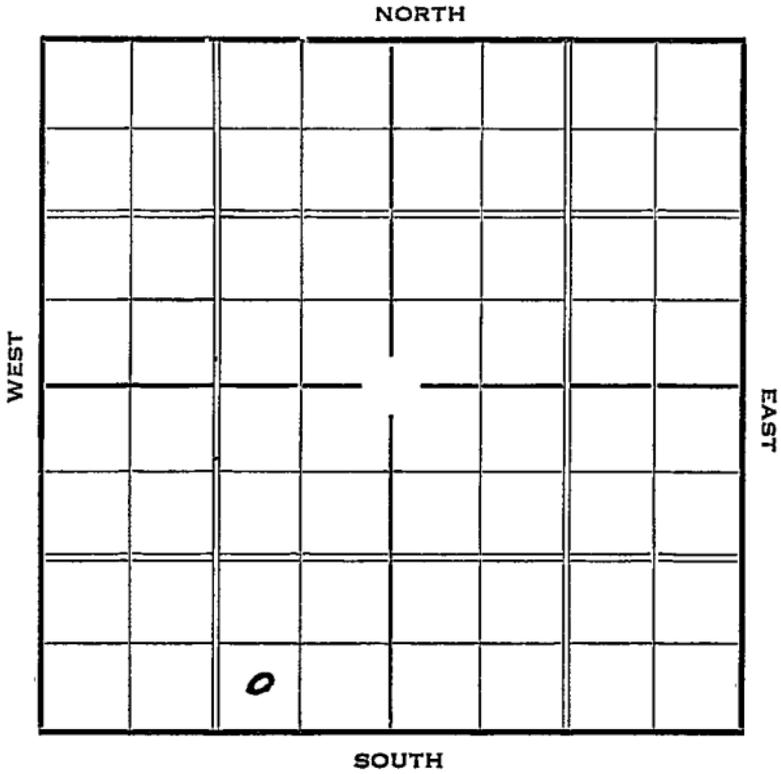

Sec. 21 Twp. 11 R. 17-W

Well No. #2 Bemis "C" Farm

Ryan Consolidated Company


\_\_\_\_\_ Ft. from N. Line

330 Ft. from S. Line

990 Ft. from E. Line

\_\_\_\_\_ Ft. from W. Line

Elev. 1939

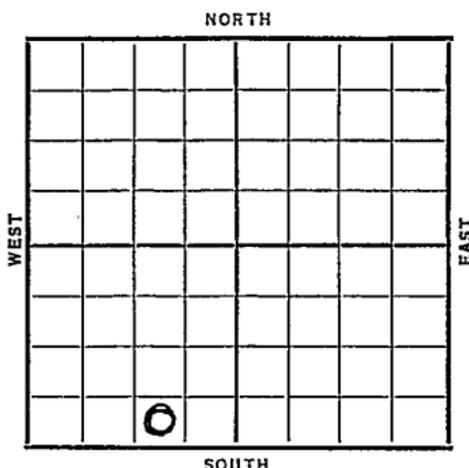

Date	REPORT
1937	
10/13	BRR
10/22	15" @ 34'. T.D. 1139'.
	Reaming.
10/29	Anhy 1158'. 10" @ 1168'.
	Drlg. 1800'.
11/5	Drlg. 3100'.
11/12	Sil. & 7" @ <sup>3433</sup> <del>3436</del> ' T.D. 3444'.
	3000' oil 1 hr.
11/17	7" @ 3433'.
	Sil. 3433'g (Corrected)
	S.L.C. 3444=3441'.
	T.D. 3441'.
	Potential 3093 bbls., Nat.
	COMPLETED

Ellis **KANSAS**  
 Map No. \_\_\_\_\_ Sec. 21 Twp. 11 R. 17W

Well No. 2 Bemis "C"

Ryan Consolidated Company

Contractor

**FIRST REPORT**

SW SE SW

\_\_\_\_\_ Ft. from N. Line

330 Ft. from S. Line990 Ft. from E. Line

\_\_\_\_\_ Ft. from W. Line

**SECTION PLAT**

	0		

Location \_\_\_\_\_

Rig up \_\_\_\_\_

Drilling and Remarks:

BRR

**RECORD**

Cased \_\_\_\_\_ in., \_\_\_\_\_ ft.

Sand \_\_\_\_\_

Gas \_\_\_\_\_

Oil \_\_\_\_\_

Total Depth \_\_\_\_\_

**PRODUCTION**

1st 24 hrs. Nat. \_\_\_\_\_

1st 24 hrs. after shot \_\_\_\_\_

Gas \_\_\_\_\_ Cu. Ft.

Dry Hole \_\_\_\_\_

Abandoned \_\_\_\_\_

Date

OCT 13 1937 19H. D. Hatfield Scout

Map No. \_\_\_\_\_ Sec. 21 Twp. 11 R. 17WWell No. 2 Bemis "C"Ryan Consolidated Company

Contractor

COMPLETED

SECTION PLAT

SW SE SW

\_\_\_\_\_ Ft. from N. Line

330 Ft. from S. Line990 Ft. from E. Line

\_\_\_\_\_ Ft. from W. Line

	0		

Location \_\_\_\_\_

Rig up \_\_\_\_\_

Drilling and Remarks:

Pot-3093

NAT

## RECORD

Cased 7 in., 3433 ft.Sand 51 3433 <sup>(corrected)</sup>Gas S.L.C., 3444 = 3441

Off \_\_\_\_\_

Total Depth 3441

## PRODUCTION

1st 24 hrs. Nat. \_\_\_\_\_

1st 24 hrs. after shot \_\_\_\_\_

Gas \_\_\_\_\_ Cu. Ft.

Dry Hole \_\_\_\_\_

Abandoned \_\_\_\_\_

Date

NOV 17 1937 19 H. D. Hatfield Scout