
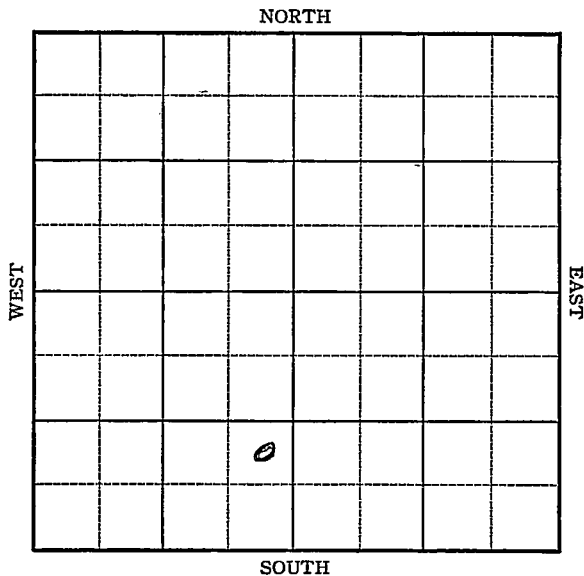


Section 21 Township 11 Range 17-WWell No. #3 Bemis "C"Company Ryan Consolidated

Sec. 21 Twp. 11 R. 17-WWell No. #3 Bemis "C" Farm
Ryan Consolidated Company Ft. from N. Line990 Ft. from S. Line330 Ft. from E. Line Ft. from W. Line

Elev. 1910

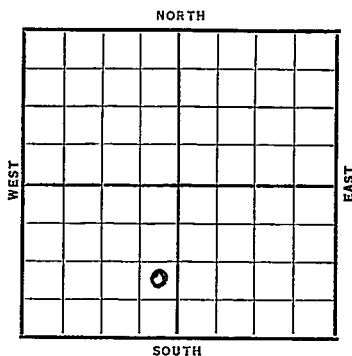

Date

REPORT

1937

10/27

Location

11/5

R. R.

11/12

15" @ 32'. Anhy 1151'.

Drlg. 1161'.

11/19

Drlg. 2176'.

11/26

Drlg. 3020'.

12/3

Sil. & 7" @ 3404'. T.D. 3405'.

WOC. No shows rept.

12/8

7" @ 3404'.

Sil. 3404'.

T.D. 3411'.

Potential 3073 bbls. Nat.

COMPLETED

Ellis KANSAS

Map No. _____ Sec. 21 Twp. 11 R. 17WWell No. 3 Bemis "C"1 Ryan Consolidated Company

Contractor

FIRST REPORT

NE SE SW

_____ Ft. from N. Line

990 Ft. from S. Line330 Ft. from E. Line

_____ Ft. from W. Line

SECTION PLAT

	0		

Location X

Rig up _____

Drilling and Remarks:

RECORD

Cased _____ in., _____ ft.

Sand _____

Gas _____

Oil _____

Total Depth _____

PRODUCTION

1st 24 hrs. Nat. _____

1st 24 hrs. after shot _____

Gas _____ Cu. Ft.

Dry Hole _____

Abandoned _____

Date

H. D. Hatfield

Scout

OCT 27 1937

Ellis

KANSAS

Map No. _____ Sec. 21 Twp. 11 R. 17WWell No. 3 Bemis "C"

Ryan Consolidated

Company

Contractor

COMPLETE

NE SE SW

_____ Ft. from N. Line

990 Ft. from S. Line330 Ft. from E. Line

_____ Ft. from W. Line

SECTION PLAT

	0		

Location _____

Rig up _____

Drilling and Remarks:

RECORD

Cased 7 in. 3404 ft.Sand sil 3404

Gas _____

Oil _____

Total Depth 3411

PRODUCTION

1st 24 hrs. Nat. _____

1st 24 hrs. after shot _____

Gas _____ Cu. Ft.

Dry Hole _____

Abandoned _____

Date

DEC 8 - 1937 19

H. D. Hatfield

Scout