

ELLIS

KANSAS

21

11


17W

SECTION _____ TOWNSHIP _____ RANGE _____

WELL NO. #7 Frank Bemis "O"

COMPANY Ryan Consolidated Corporation

NORTH

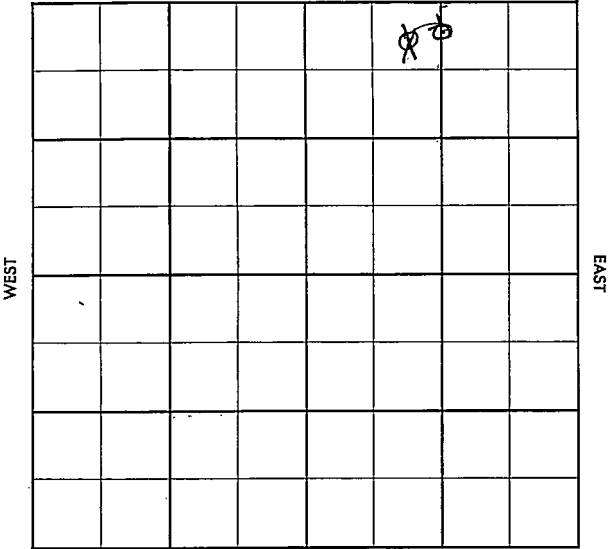

SOUTH

SEC. 21	TWP. _ 111	R. 17W
------------	---------------	-----------

WELL NO. #7 Frank Bemis ~~111~~ "0" FARM

COMPANY Ryan Consolidated Corp.

CONTRACTOR Glen Peel

Bemis-Shutts

_____ FT. FROM N. LINE	
_____ FT. FROM S. LINE	
_____ FT. FROM E. LINE	
_____ FT. FROM W. LINE	

~~NE-NW-NE~~
N/2 N/2

1956	ELEVATION 1827'	REPORT
------	--------------------	--------

6-13 Location
7-85 Comm. 6-12-56
10 3/4" @ 1041 w/600
Cored 335-93 rec. 58'
7" @ 3420
CO 3387; 10/3340-50; tst wtr.
sqd.
CO 3387; 40/3340-50
S/ 600 BFPD, 2% oil,
Est P/ 50 BO / 3000 BWPD
A. 3342';
TD 3421'

COMPLETED

County ELLIS Elev. _____
 Sec. 21 Twp. 11 Rgs. 17W
 Company Ryan Consolidated Corp.
 Farm Name Frank Bemis #1011 No. 7

TOPS	DEPTH	LOG	DATUM
Anh.			
Tp.			
H.			
Tr.			
Dg.			
Bl.			
L.			
K.C.			
B.K.C.			
Ce.			
C.			
M.			
M.			
K.			
Mz.			
Me.			
V.			
S.			
S.			
A.			
R.			
PE.			
G.			
T.R.			

Loc. in Sec. NE NW NE

Geol. _____

Contr. _____

Glac. Pool

Pool _____

Bemis-Shuttles

		0
FIRST REPORT		
	JUN 13 1935	

Date Comm. _____

Location

JUN 12 1935

B G

Co.

Lse.

No.

Sec.

T.

R.

CORRECTION

FORM 513 SUNRAY

Co.

Lse.

No.

Sec.

T

R

County EMILS Elev. 1827
 Sec. 21 Twp. 11 Rge. 17W
 Company Ryan Consolidated Corp.
 Farm Name Frank Bemis "O" No. 7

TOPS	DEPTH	LOG	DATUM	Loc. in Sec.
Anh.				<div style="border: 1px solid black; border-radius: 50%; padding: 5px; display: inline-block;"> 117 N2 N2 </div>
Tp.				
H.				
Tr.				
Dg.				
Bl.				
L.				
K.C.				
B.K.C.				
Ce.				
C.				Geol. _____
M.				Contr. _____
M.				len Peel
K.				Pool _____
Mz.				Bemis-Shutts
Ma.				
V.				
S.				
S.				
A.	3342			COMPLETE
R.				
Pe.				JUL 25 1956
G.				
T.D.	3421			

Date Comm. (no geologist)
 Location JUN 20 '56 6-12-56 10 3/4
@ 1041/600 @ 2800 JUN 27 '56
crd 3335-93' rec 58' 7" @ 3420
JUL 2 '56 WOCT JUL 11 '56 MICT JUL 18 '56
CO 3387 10/3340-56 fst wta
59d CO 3387 JUL 25 '56 40/3340-50
\$ 600⁺ BFpd 290 oil est P.
50 B0 + 3000 Bwld (Reda Pump)