

KANSAS


Ellis

Form 51-5M-7-39-Palace

Section 21 Township 11 Range 17-W

Well No. #2 Hadley

Company Winkler & Koch
Bemis Pool

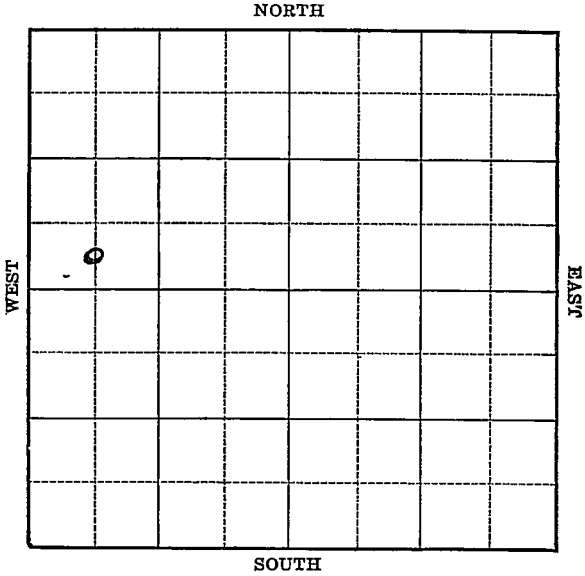

Sec. 21 Twp. 11 R. 17-W

Well No. #2 Hadley Farm
Winkler & Koch Company


(Bemis)

_____ Ft. from N. Line

330 Ft. from S. Line

_____ Ft. from E. Line

660 Ft. from W. Line

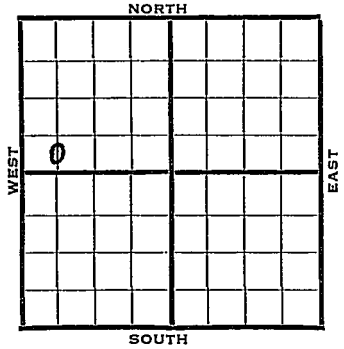

1940	REPORT
6/12	Rotary.
6/20	13" - 85' Anhy 1080' Drlg. 2710'
6/27	Arb. 3410' Set 7" - 3410' RUST.
7/3	" " " " " "
7/11	" " " " " "
7/17	Arb. 3408' 7" - 3408' T.D. 3410' 2000 acid. Echometer potential 2261 bbls.

COMPLETED

Map No. 71 Sec. 21 Twp. 11 R. 17W

Well No. 2 Hadley

Winkler & Koch Company

Contractor

FIRST REPORT

C S L SW NW

SECTION PLAT

_____ Ft. from N. Line

330 Ft. from S. Line

_____ Ft. from E. Line

660 Ft. from W. Line

BEMIS POOL

Location _____

Rig up _____

Drilling and Remarks:

Rotary

RECORD

Cased _____ in., _____ ft.

Sand _____

Gas _____

Oil _____

Total Depth _____

PRODUCTION

1st 24 hrs. Nat. _____

1st 24 hrs. after shot _____

Gas _____ Cu. Ft.

Dry Hole _____

Abandoned _____

Date

JUN 12 1940 19

S. J. LEWIS Scout

Map No. _____ Sec. 21 Twp. 11 R. 17W

Well No. 2 Hadley

Winkler & Koch Company

Contractor

COMPLETED

C S L SW NW

_____ Ft. from N. Line

330 Ft. from S. Line

_____ Ft. from E. Line

660 Ft. from W. Line

BEMIS POOL

SECTION PLAT

Location _____

Rig up _____

Drilling and Remarks:

Ac 8408
7" @ 3408
2000 acal
Eckometel
2261

RECORD

Cased _____ in., _____ ft.

Sand _____

Gas _____

Oil _____

Total Depth 3410

PRODUCTION

1st 24 hrs. Nat. _____

1st 24 hrs. after shot _____

Gas _____ Cu. Ft.

Dry Hole _____

Abandoned _____

Date

JUL 17 1940

S. J. LEWIS Scout